

CARD MUST BE TYPED

State of Kansas
NOTICE OF INTENTION TO DRILL
(see rules on reverse side)

CARD MUST BE SIGNED

Starting Date: July 12 1984
month day year

API Number 15- 095-21,472 000

OPERATOR: License # 5050
Name Hummon Corporation
Address 400 One Main Place
City/State/Zip Wichita, Kansas 67202
Contact Person Wilber Berg
Phone 263-8521

C. NE SW Sec. 13 Twp 29 S, Rge 10
(location) East West

1980 Ft North from Southeast Corner of Section
3300 Ft West from Southeast Corner of Section
(Note: Locate well on Section Plat on reverse side)

CONTRACTOR: License # 5148
Name Big-H Drilling, Inc.
City/State 400 One Main Place, Wichita, KS

Nearest lease or unit boundary line 660 feet.
County Kingman
Lease Name Adelhardt Well# 1

Domestic well within 330 feet: yes no
Municipal well within one mile: yes no

Well Drilled For: Well Class: Type Equipment:
 Oil Swd Infield Mud Rotary
 Gas Inj Pool Ext. Air Rotary
 OWWO Expl Wildcat Cable

Depth to Bottom of fresh water 100 feet
Lowest usable water formation Salt Plain Slr
Depth to Bottom of usable water 200 feet
Surface pipe by Alternate: 1 2
Surface pipe to be set 200 feet
Conductor pipe if any required feet
Ground surface elevation feet MSL
This Authorization Expires 1/10/85
Approved By 7/10/84

If OWWO: old well info as follows:

Operator
Well Name
Comp Date Old Total Depth
Projected Total Depth 2800 feet
Projected Formation at TD Indian Cave
Expected Producing Formations

I certify that we will comply with K.S.A. 55-101, et seq., plus eventually plugging hole to K.C.C. specifications.

Date 7-9-84 Signature of Operator or Agent

Kenneth S. White Agent

2249 WANE 7-10-84


Must be filed with the K.C.C. five (5) days prior to commencing well
 This card void if drilling not started within six (6) months of date received by K.C.C.

RECEIVED
 STATE CORPORATION COMMISSION

07-10-84
 JUL 10 1984

Important procedures to follow

A Regular Section of Land
1 Mile = 5,280 Ft.

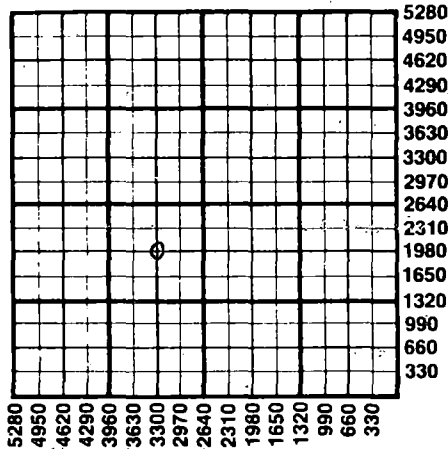

1. Notify District office before setting surface casing.
2. Set surface casing by circulating cement to the well, Kansas
3. File completion forms ACO-1 with K.C.C. within 90 days of well completion, following instructions on ACO-1, side 1, and including copies of wireline logs.
4. Notify District office 48 hours prior to old well workover or re-entry.
5. Prior to plugging, prepare a plugging plan, then obtain agreement from the appropriate district office for an approved plugging plan.
6. Submit plugging report (CP-4) to K.C.C. after plugging is completed.
7. Obtain an approved injection docket number before disposing of salt water.
8. Notify K.C.C. within 10 days when injection commences or terminates.
9. If an alternate 2 completion, cement in the production pipe from below any usable water to surface within 120 days of spud date.

State Corporation Commission of Kansas
 Conservation Division
 200 Colorado Derby Building
 Wichita, Kansas 67202
 (316) 263-3238