

CARD MUST BE TYPED

State of Kansas

CARD MUST BE SIGNED

NOTICE OF INTENTION TO DRILL

(see rules on reverse side)

✓ SIC

Expected Spud Date. . . . . 4 4 88  
month day year

API Number 15-095-21,587-00-00

OPERATOR: License # 5123  
Name Pickrell Drilling Company, Inc.  
Address 110 N. Market, Suite 205  
City/State/Zip Wichita, Kansas 67202  
Contact Person Jay McNeil  
Phone 262-8427

N/2 SE NW Sec. 36 Twp. 29 S, Rg. 7 X East  
3630 West  
3300 Ft. from South Line of Section  
Ft. from East Line of Section

(Note: Locate well on Section Plat on reverse side)

CONTRACTOR: License # 5123  
Name Pickrell Drilling Company, Inc.  
City/State Wichita, Kansas

Nearest lease or unit boundary line 660 feet  
County Kingman 1  
Lease Name Coykendall Well # 8

Well Drilled For: Well Class: Type Equipment:  
X Oil Storage X Infield X Mud Rotary  
X Gas Inj Pool Ext Air Rotary  
OWWO Expl Wildcat Cable

Ground surface elevation 1475 feet MSL  
Domestic well within 330 feet: \_\_\_yes X no  
Municipal well within one mile: \_\_\_yes X no

If OWWO: old well info as follows:  
Operator  
Well Name  
Comp Date Old Total Depth

Depth to bottom of fresh water 75  
Depth to bottom of usable water 150  
Surface pipe by Alternate: 1 X 2  
Surface pipe planned to be set 240'  
Conductor pipe required  
Projected Total Depth 4200' feet  
Formation Mississippian

I certify that well will comply with K.S.A. 55-101, et seq., plus eventually plugging hole to KCC specifications.  
Date 3-31-88 Signature of Operator or Agent Title Chief Geologist

For KCC Use:  
Conductor Pipe Required feet; Minimum Surface Pipe Required 200 feet per Alt. 1 X  
This Authorization Expires 10-1-88 Approved By PCH 3-31-88


EFFECTIVE DATE 4-5-88

Must be filed with the K.C.C. five (5) days prior to commencing well  
This card void if drilling not started within six (6) months of date received by K.C.C.

### Important procedures to follow:

1. Notify District office before setting surface casing.
2. Set surface casing by circulating cement to the top.
3. File completion forms ACO-1 with K.C.C. within 120 days of well spud date, following instructions on ACO-1, side 1, and including copies of wireline logs.
4. Notify District office 48 hours prior to old well workover or re-entry.
5. Prior to filing Intent, prepare a proposed plugging plan in case well is D & A, then obtain approval of plan when calling district office prior to setting surface pipe.
6. Submit plugging report (CP-4) to K.C.C. after plugging is completed.
7. Obtain an approved injection docket number before disposing of salt water.
8. Notify K.C.C. within 10 days when injection commences or terminates.
9. If an alternate 2 completion, cement in the production pipe from below any usable water to surface within 120 days of spud date.

### A Regular Section of Land 1 Mile = 5,280 Ft.

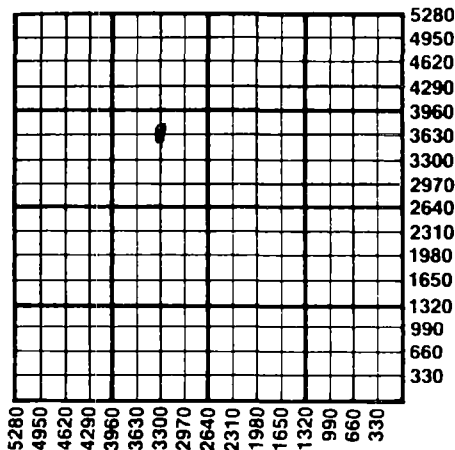

RECEIVED  
STATE CORPORATION COMMISSION

MAR 31 1988  
3-31-88  
CONSERVATION DIVISION  
Wichita, Kansas

State Corporation Commission of Kansas  
Conservation Division  
200 Colorado Derby Building  
Wichita, Kansas 67202-1212  
(316) 263-3238