

NOTICE OF INTENTION TO DRILL

(see rules on reverse side)

Starting Date 5 7 1987 month day year

API Number 15-083-21,278-0000

OPERATOR: License # 6785 Name Robert Schulein Address 1776 Lincoln St., #811 City/State/Zip Denver, Colorado 80203 Contact Person Robert Schulein Phone (303) 839-5495

C SE SE Sec 9 Twp 24 S, Rg 22 X West 660 Ft. from South Line of Section 660 Ft. from East Line of Section

(Note: Locate well on Section Plat on reverse side)

CONTRACTOR: License # 5302 Name Red Tiger Drilling Co. City/State Wichita, Kansas 67202

Nearest lease or unit boundary line 660 feet County Hodgeman

Lease Name Herrmann Well # 16-9

Ground surface elevation 2380 feet MSL

Well Drilled For: XX Oil SWD Infield XX Mud Rotary Gas Inj Pool Ext Air Rotary OWWO Expl Wildcat Cable

Domestic well within 330 feet: yes X no

Municipal well within one mile: yes X no

Surface pipe by Alternate: 1 X 2

Depth to bottom of fresh water 240'

Depth to bottom of usable water 400'

Surface pipe planned to be set 400'

Projected Total Depth 4700 feet

Formation Mississippian

If OWWO: old well info as follows:

Operator Well Name Comp Date Old Total Depth

I certify that well will comply with K.S.A. 55-101, et seq., plus eventually plugging hole to KCC specifications.

cementing will be done immediately upon setting production casing.

Date April 16, 1987 Signature of Operator or Agent Title Owner/Operator

For KCC Use:

Conductor Pipe Required feet; Minimum Surface Pipe Required 400 feet per Alt.


This Authorization Expires 10-20-87 Approved By 4-20-87

Must be filed with the K.C.C. five (5) days prior to commencing well  
 This card void if drilling not started within six (6) months of date received by K.C.C.

**Important procedures to follow:**

1. Notify District office before setting surface casing.
2. Set surface casing by circulating cement to the top.
3. File completion forms ACO-1 with K.C.C. within 90 days of well completion, following instructions on ACO-1, side 1, and including copies of wireline logs.
4. Notify District office 48 hours prior to old well workover or re-entry.
5. Prior to filing Intent, prepare a proposed plugging plan in case well is D & A, then obtain approval of plan when calling district office prior to setting surface pipe.
6. Submit plugging report (CP-4) to K.C.C. after plugging is completed.
7. Obtain an approved injection docket number before disposing of salt water.
8. Notify K.C.C. within 10 days when injection commences or terminates.
9. If an alternate 2 completion, cement in the production pipe from below any usable water to surface within 120 days of spud date.

**A Regular Section of Land**  
 1 Mile = 5,280 Ft.

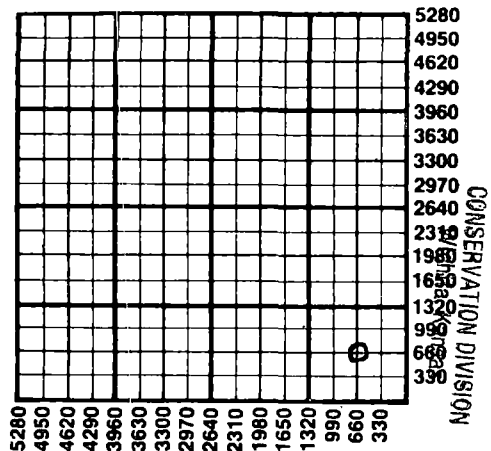

CONSERVATION DIVISION

APR 20 1987

STATE CORPORATION COMMISSION RECEIVED

State Corporation Commission of Kansas  
 Conservation Division  
 200 Colorado Derby Building  
 Wichita, Kansas 67202  
 (316) 263-3238