

CARD MUST BE TYPED

State of Kansas

CARD MUST BE SIGNED

NOTICE OF INTENTION TO DRILL

(see rules on reverse side)

Expected Spud Date... 11 month 16 day 1987 year

API Number 15- 095-21,577 0000 150' NE of SW. NE. NE. Sec. 36 Twp. 29S, Rg. 9 4380 Ft. from South Line of Section 900 Ft. from East Line of Section

OPERATOR: License # 5042 Name Edmiston Oil Company, Inc. Address 1260 KSB Bldg. City/State/Zip Wichita, KS 67202 Contact Person Jon M. Callen Phone 316 265-5241

(Note: Locate well on Section Plat on reverse side) Nearest lease or unit boundary line 900 feet County Kingman Lease Name HARTSHORN Well # 1

CONTRACTOR: License # 5107 Name H-30, Inc. City/State Wichita, KS

Ground surface elevation 1639 feet MSL Domestic well within 330 feet: yes no X

Well Drilled For: Well Class: Type Equipment: Oil Storage Infield X Mud Rotary X Gas Inj X Pool Ext. Air Rotary OWWO Expl Wildcat Cable

Municipal well within one mile: yes no X Depth to bottom of fresh water 60' Depth to bottom of usable water 200'

If OWWO: old well info as follows: Operator Well Name Comp Date Old Total Depth

Surface pipe by Alternate: 1 X 2 Surface pipe planned to be set 300 Conductor pipe required Projected Total Depth 4600 feet Formation Arbuckle

I certify that well will comply with K.S.A. 55-101, et seq., plus eventually plugging hole to KCC specifications. Date 11/9/87 Signature of Operator or Agent Jon M. Callen Title Vice-President

For KCC Use: Conductor Pipe Required feet; Minimum Surface Pipe Required 200 feet per Alt. X This Authorization Expires 5-10-88 Approved By P.H. 11-10-87


EFFECTIVE DATE: 11-15-87

Must be filed with the K.C.C. five (5) days prior to commencing well
This card void if drilling not started within six (6) months of date received by K.C.C.

Important procedures to follow:

1. Notify District office before setting surface casing.
2. Set surface casing by circulating cement to the top.
3. File completion forms ACO-1 with K.C.C. within 120 days of well spud date, following instructions on ACO-1, side 1, and including copies of wireline logs.
Notify District office 48 hours prior to old well workover or re-entry.
4. Prior to filing Intent, prepare a proposed plugging plan in case well is D & A, then obtain approval of plan when calling district office prior to setting surface pipe.
6. Submit plugging report (CP-4) to K.C.C. after plugging is completed.
7. Obtain an approved injection docket number before disposing of salt water.
8. Notify K.C.C. within 10 days when injection commences or terminates.
9. If an alternate 2 completion, cement in the production pipe from below any usable water to surface within 120 days of spud date.

A Regular Section of Land 1 Mile = 5,280 Ft.

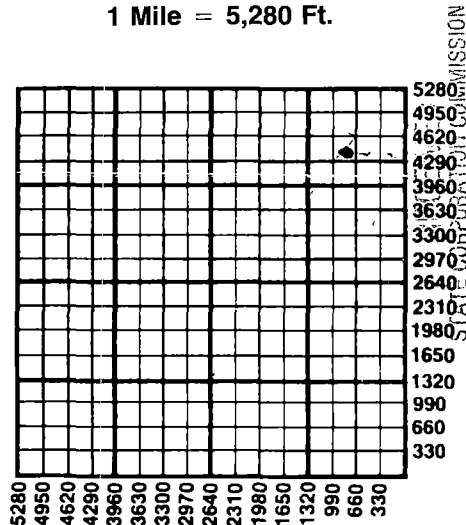

NOV 10 1987
11-10-87

CONSERVATION DIVISION
Wichita, Kansas

State Corporation Commission of Kansas
Conservation Division
200 Colorado Derby Building
Wichita, Kansas 67202-1212
(316) 263-3238