

CARD MUST BE TYPED

State of Kansas

CARD MUST BE SIGNED

NOTICE OF INTENTION TO DRILL

(see rules on reverse side)

"CORRECTED SPOT LOC."

CORRECTED
12-23-86

Starting Date 12 29 86
month day year

API Number 15- 095-01,007 0001
490 FSL: 680' FEL SW/4
..... 490 Sec. 8 Twp. 30S S, Rg. 5W X East
* 3320 Ft. from South Line of Section
..... Ft. from East Line of Section

OPERATOR: License # 5922
Name VANMAX EXPLORATION, INC.
Address Landmark Square, Ste. 503
City/State/Zip Wichita, Kansas 67202
Contact Person C. C. Van Buskirk
Phone 316-262-5646

(Note: Locate well on Section Plat on reverse side)
Nearest lease or unit boundary line 490 feet
County Kingman
Lease Name Fink Well # 2

CONTRACTOR: License # 5302
Name Red Tiger Drilling Co.
City/State Wichita, Kansas 67202

Ground surface elevation 1431 feet MSL
Domestic well within 330 feet: yes X no
Municipal well within one mile: yes X no

Well Drilled For: Well Class: Type Equipment:
X Oil SWD Infield X Mud Rotary
Gas Inj Pool Ext Air Rotary
OWWO Expl Wildcat Cable

Depth to bottom of fresh water 50
Depth to bottom of usable water 200
Surface pipe by Alternate: 1 X 2

If OWWO: old well info as follows:
Operator Pickerell Drilling Company
Well Name #2 Fink
Comp Date 6-1-66 Old Total Depth 3680

Surface pipe ~~1 1/2~~ set 203' 8 5/8"/150 SX
Conductor pipe required N/A
Projected Total Depth 4600 feet
Formation Simpson

I certify that well will comply with K.S.A. 55-101, et seq., plus eventually plug and hole KCC specifications.
Date 12-19-86 Signature of Operator or Agent Kay A. Cagle Title Owner

For KCC Use:
Conductor Pipe Required feet; Minimum Surface Pipe Required 103 feet per Alt. ① 2
This Authorization Expires 6-19-87 Approved By 12-19-86


*was 3220 FEL

Must be filed with the K.C.C. five (5) days prior to commencing well
This card void if drilling not started within six (6) months of date received by K.C.C.

Important procedures to follow:

1. Notify District office before setting surface casing.
2. Set surface casing by circulating cement to the top.
3. File completion forms ACO-1 with K.C.C. within 90 days of well completion, following instructions on ACO-1, side 1, and including copies of wireline logs.
4. Notify District office 48 hours prior to old well workover or re-entry.
5. Prior to filing Intent, prepare a proposed plugging plan in case well is D & A, then obtain approval of plan when calling district office prior to setting surface pipe.
6. Submit plugging report (CP-4) to K.C.C. after plugging is completed.
7. Obtain an approved injection docket number before disposing of salt water.
8. Notify K.C.C. within 10 days when injection commences or terminates.
9. If an alternate 2 completion, cement in the production pipe from below any usable water to surface within 120 days of spud date.

**A Regular Section of Land
1 Mile = 5,280 Ft.**

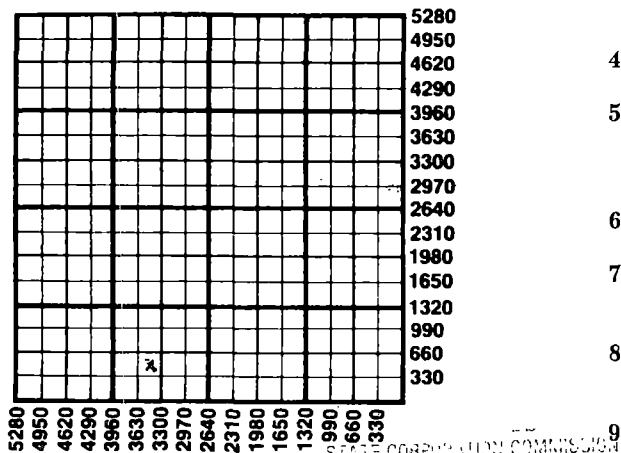

DEC 22 1986
12-22-86
CONSERVATION DIVISION
Wichita, Kansas

State Corporation Commission of Kansas
Conservation Division
200 Colorado Derby Building
Wichita, Kansas 67202
(316) 263-3238