

FORM MUST BE TYPED
FORM C-1 12/88

EFFECTIVE DATE: 4/20/90 State of Kansas
NOTICE OF INTENTION TO DRILL

FORM MUST BE SIGNED
ALL BLANKS MUST BE FILLED

Must be approved by the K.C.C. five (5) days prior to commencing well

Expected Spud Date ... 4 month ... 28 day ... 90 year

47' S c E/2 SW SW ✓
Sec 24 Twp 30 S, Rg 5 East West ✓

613 feet from South line of Section
4290 feet from East line of Section
(Note: Locate well on Section Plat Below)

OPERATOR: License # 5038 ✓
Name: ROBINSON OIL COMPANY
Address: 300 W. Douglas #420
City/State/Zip: Wichita, KS 67202
Contact Person: Bruce or Jim Robinson
Phone: (316) 262-6734 / (316) 722-7945

County: Kingman
Lease Name: Pomeroy "A" Well #: 1
Field Name: Bogle

CONTRACTOR: License # 5864 ✓
Name: LOBO Drilling Co.

Is this a Prorated Field? ... yes X no

Well Drilled For: Well Class: Type Equipment:
X Oil ... Inj ... Infield X Mud Rotary
... Gas ... Storage ... Pool Ext. ... Air Rotary
... OMO ... Disposal X Wildcat ... Cable
... Seismic; ... # of Holes

Target Formation(s): Kansas City
Nearest lease or unit boundary: 613
Ground Surface Elevation: 1435 feet MSL

If OMO; old well information as follows:
Operator: _____
Well Name: _____
Comp. Date: _____ Old Total Depth _____

Domestic well within 330 feet: ... yes X no
Municipal well within one mile: ... yes X no

Directional, Deviated or Horizontal wellbore? ... yes X no
If yes, total depth location: _____
* WAS 5/2 SW5W
* WAS 330' FSL
* WAS 4620' FEL

-Depth to bottom of fresh water: 50
-Depth to bottom of usable water: 180

AFFIDAVIT

Surface Pipe by Alternate: X 1 ... 2
-Length of Surface Pipe Planned to be set: 220'

Length of Conductor pipe required: none
Projected Total Depth: 3800'

Formation at Total Depth: Kansas City
Water Source for Drilling Operations:
... well ... farm pond X other

DWR Permit #: _____
Will Cores Be Taken?: ... yes X no

If yes, proposed zone: _____
* WAS 330' NLL
* WAS 1430' GL


The undersigned hereby affirms that the drilling, completion and eventual plugging of this well will comply with K.S.A. 55-101, et. seq.

It is agreed that the following minimum requirements will be met:

1. The appropriate district office shall be notified before setting surface pipe;
2. The minimum amount of surface pipe as specified above shall be set by circulating cement to the top; in all cases surface pipe shall be set through all unconsolidated materials plus a minimum of 20 feet into the underlying formation;
3. If the well is dry, a plugging proposal shall be submitted to the district office. An agreement between the operator and the district office on plug length and placement is necessary prior to plugging;
4. The appropriate district office will be notified before well is either plugged or production casing is cemented in;
5. If an Alternate II completion, production pipe shall be cemented from below any usable water to surface within 120 days of spud date. In all cases, notify district office prior to any cementing.

I hereby certify that the statements made herein are true and to the best of my knowledge and belief.

Date: 4-20-90 signature of Operator or Agent: Bruce Johnson Title: Operator

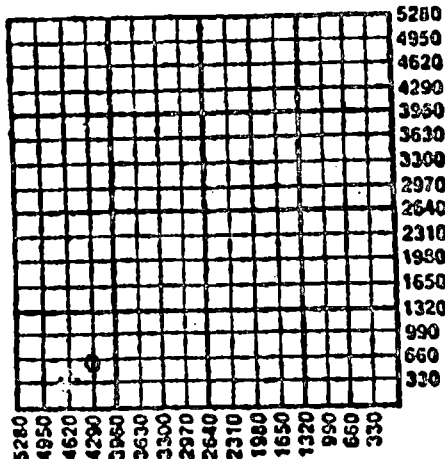

RECEIVED
STATE CORPORATION COMMISSION
APR 20 1990
CONSERVATION DIVISION
Wichita, Kansas
APR 27 1990
RECEIVED
STATE CORPORATION COMMISSION
CONSERVATION DIVISION
Wichita, Kansas

FOR KCC USE:
API # 15- 095-21,635-0000 dry ✓
Conductor pipe required NONE feet
Minimum surface pipe required 200' feet per Alt. OX
Approved by: BCE 4/23/90, BGF 4/30/90
EFFECTIVE DATE: 4/20/90
This authorization expires: 6/23/90
(This authorization void if drilling not started within 6 months of effective date.)
Spud date: _____ Agent: _____

REMEMBER TO:

- File Drill Pit Application (form CDP-1) with Intent to Drill;
- File Completion Form ACO-1 within 120 days of spud date;
- Decrease attribution plat according to field proration orders;
- Notify appropriate district office 48 hours prior to workover or re-entry;
- Submit plugging report (CP-4) after plugging is completed;
- Obtain written approval before disposing or injecting salt water.