

CARD MUST BE TYPED

State of Kansas

CARD MUST BE SIGNED

NOTICE OF INTENTION TO DRILL

Expected Spud Date: January 4 1988 (see rules on reverse side)

API Number 15-095-21,581 0000

VDA

OPERATOR: License # 5673
Name: W. L. Kirkman, Inc.
Address: P.O. Box 782290
City/State/Zip: Wichita, Kansas 67278-2290
Contact Person: W. L. Kirkman
Phone: (316) 685-5372

NE.. SW.. NW Sec. 25.. Twp. 30.. S, Rg. 5... X West
3630 Ft. from South Line of Section
4290 Ft. from East Line of Section

(Note: Locate well on Section Plat on reverse side)

CONTRACTOR: License # 5122
Name: Woodman-Iannitti Drilling Co.
City/State: Great Bend, Kansas 67530

Nearest lease or unit boundary line 990 feet
County: Kingman
Lease Name: Bogle Well # A-1
Ground surface elevation 1450 est. feet MSL
Domestic well within 330 feet: yes no
Municipal well within one mile: yes no
Depth to bottom of fresh water none 50
Depth to bottom of usable water none 180
Surface pipe by Alternate: 1 XX 2

Well Drilled For: Well Class: Type Equipment:
X Oil Storage Infield X Mud Rotary
Gas Inj Pool Ext Air Rotary
OWWO Expl Wildcat Cable

If OWWO: old well info as follows:

Surface pipe planned to be set 250
Conductor pipe required no
Projected Total Depth 3800 feet
Formation: Kansas City

Operator
Well Name
Comp Date Old Total Depth

I certify that well will comply with K.S.A. 55-101, et seq., plus eventually plugging hole to KCC specifications.

Date 12/27/87 Signature of Operator or Agent Title Owner

For KCC Use:

Conductor Pipe Required feet; Minimum Surface Pipe Required 200 feet per Alt. 1 X
This Authorization Expires 7-1-88 Approved By RCH 12-31-88


EFFECTIVE DATE: 1-5-88

Must be filed with the K.C.C. five (5) days prior to commencing well  
This card void if drilling not started within six (6) months of date received by K.C.C.

### Important procedures to follow:

1. Notify District office before setting surface casing.
2. Set surface casing by circulating cement to the top.
3. File completion forms ACO-1 with K.C.C. within 120 days of well spud date, following instructions on ACO-1, side 1, and including copies of wireline logs.
4. Notify District office 48 hours prior to old well workover or re-entry.
5. Prior to filing Intent, prepare a proposed plugging plan in case well is D & A, then obtain approval of plan when calling district office prior to setting surface pipe.
6. Submit plugging report (CP-4) to K.C.C. after plugging is completed.
7. Obtain an approved injection docket number before disposing of salt water.
8. Notify K.C.C. within 10 days when injection commences or terminates.
9. If an alternate 2 completion, cement in the production pipe from below any usable water to surface within 120 days of spud date.

### A Regular Section of Land 1 Mile = 5,280 Ft.

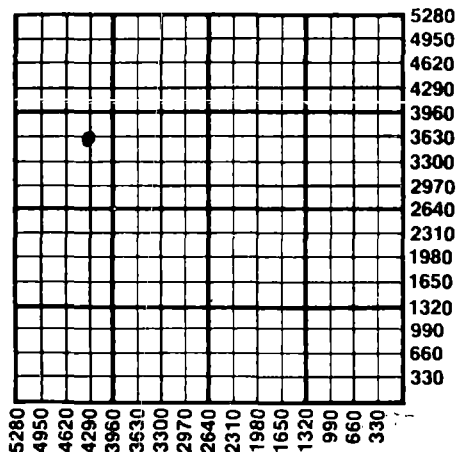

DEC 3 - 1987  
12-31-87  
CONSERVATION DIVISION  
WICHITA, KANSAS

State Corporation Commission of Kansas  
Conservation Division  
200 Colorado Derby Building  
Wichita, Kansas 67202-1212  
(316) 263-3238