

This form shall be filed in duplicate with the Kansas Corporation Commission, 200 Colorado Derby Building, Wichita, Kansas 67202, within ten days after the completion of the well, regardless of how the well was completed.

X Attach separate letter of request if the information is to be held confidential. If confidential, only file one copy. Information on side one will be of public record and side two will then be held confidential.

Circle one: (Oil) Gas, Dry, SWD, OWWO, Injection. Type and complete ALL sections. Applications must be filed for dual completion, commingling, SWD and injection, T.A.

Attach wireline logs (i.e. electrical log, sonic log, gamma ray neutron log, etc.). KCC # (316) 263-3238. (Rules 82-2-105 & 82-2-125)

OPERATOR CINCO EXPLORATION COMPANY
c/o Melvin Klotzman
ADDRESS P.O. Box 3723
Victoria, Texas 77903

API NO. 15-155-20854 - 0600
COUNTY Reno
FIELD Zenith-Peace Creek

**CONTACT PERSON Melvin Klotzman
PHONE 1-800-531-3640

PROD. FORMATION Viola
LEASE Eva O. Martin

PURCHASER Permian Corp.
ADDRESS P.O. Box 641
Hays, Kansas 67601


WELL NO. 1
WELL LOCATION C SE SE

DRILLING Brandt Drilling Co., Inc.
CONTRACTOR
ADDRESS 1200 Douglas Building
Wichita, Kansas 67202

660 Ft. from E Line and
660 Ft. from S Line of
the C SE SEC. 10 TWP. 235 RGE. 10W

PLUGGING STATE CORPORATION COMMISSION
CONTRACTOR
ADDRESS 2-10-82 FFR 10 1082
CONSERVATION DIVISION
Wichita, Kansas

SE WELL PLAT

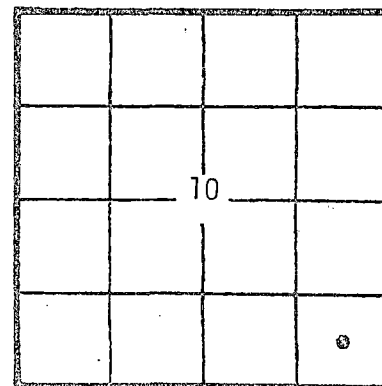

KCC [checked]
KGS [checked]
(Office Use)

TOTAL DEPTH 3770 PBD 3763

SPUD DATE 12/7/81 DATE COMPLETED 12/13/81

ELEV: GR 1769 DF -- KB 1776

DRILLED WITH (XXX) (ROTARY) XXXX TOOLS

Amount of surface pipe set and cemented 8 joints 8-5/8" set. DV Tool Used? No
at 300'.

AFFIDAVIT

STATE OF Texas, COUNTY OF Victoria SS, I, Melvin Klotzman OF LAWFUL AGE, BEING FIRST DULY SWORN UPON HIS OATH,

DEPOSES THAT HE IS Petroleum Consultant (FOR) (XX) CINCO EXPLORATION COMPANY OPERATOR OF THE Eva O. Martin LEASE, AND IS DULY AUTHORIZED TO MAKE

THIS AFFIDAVIT FOR AND, ON THE BEHALF OF SAID OPERATOR, THAT WELL NO. 1 ON SAID LEASE HAS BEEN COMPLETED AS OF THE 22nd DAY OF January, 19 82, AND THAT ALL INFORMATION ENTERED HEREIN WITH RESPECT TO SAID WELL IS TRUE AND CORRECT.

FURTHER AFFIANT SAITH NOT.

(S) [Signature] Melvin Klotzman

SUBSCRIBED AND SWORN BEFORE ME THIS 8th DAY OF February, 19 82.

[Signature] NOTARY PUBLIC

MY COMMISSION EXPIRES: 2-06-85

**The person who can be reached by phone regarding any questions concerning this information. Within 45 days of completion, a witnessed initial test by the Commission is required if the well produces more than 25 BOPD or is located in a Basic Order Pool.