

15-083-20505-0000

STATE OF KANSAS
STATE CORPORATION COMMISSION

WELL PLUGGING RECORD

Give All Information Completely
Make Required Affidavit
Mail or Deliver Report to
Conservation Division
State Corporation Comm.
245 North Water
Wichita, KS 67202

Hodgeman County. Sec. 16 Twp. 24S Rge. 23W E/W
Location as "NE/CNW $\frac{1}{4}$ SW $\frac{1}{4}$ " or footage from lines
SE $\frac{1}{4}$ NW $\frac{1}{4}$ NW $\frac{1}{4}$

Lease Owner Graham-Michaelis Corporation
Lease Name Fagen Well No. 1-16

Office Address P. O. Box 247, Wichita, Kansas 67201

Character of Well (Completed as Oil, Gas or Dry Hole)
D & A

Date Well completed November 30, 19 76

Application for plugging filed November 30, 19 76

Application for plugging approved November 30, 19 76

Plugging commenced November 30, 19 76


Plugging completed November 30, 19 76

Reason for abandonment of well or producing formation
D & A

If a producing well is abandoned, date of last production
19

Was permission obtained from the Conservation Division or
its agents before plugging was commenced? Yes

Name of Conservation Agent who supervised plugging of this well Edgar J. Eves
Producing formation _____ Depth to top _____ Bottom _____ Total Depth of Well 4,765'
Show depth and thickness of all water, oil and gas formations.

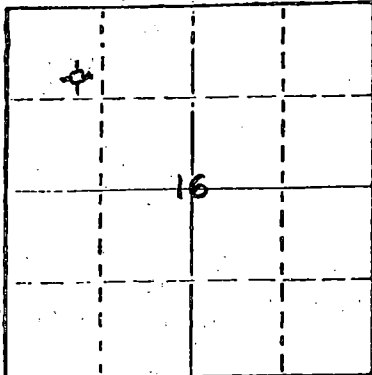

Locate well correctly on above
Section Plat

OIL, GAS OR WATER RECORDS

CASING RECORD

FORMATION	CONTENT	FROM	TO	SIZE	PUT IN	PULLED OUT
				8 5/8"	320'	-0-

Describe in detail the manner in which the well was plugged, indicating where the mud fluid
was placed and the method or methods used in introducing it into the hold. If cement or other
plugs were used, state the character of same and depth placed, from _____ feet to
_____ feet for each plug set.

Plug @ 660' w/70 sx cement

Plug @ 300' w/20 sx cement

Plug @ 40' w/10 sx cement

RECEIVED
STATE CORPORATION COMMISSION
DEC 09 1976
12-9-76
CONSERVATION DIVISION
Wichita, Kansas

(If additional description is necessary, use BACK of this sheet)

Name of Plugging Contractor Red Tiger Drilling Company
1720 KSB&T Building, Wichita, Kansas 67202

STATE OF Kansas COUNTY OF Sedgwick, ss.

Gloria Fawcett (employee of owner) or (owner)


of the above-described well, being first duly sworn on oath, says: That I have knowledge of
the facts, statements, and matters herein contained and the log of the above-described well
as filed and that the same are true and correct. So help me God.

(Signature) Gloria Fawcett
1720 KSB&T Building, Wichita, Kansas 67202
(Address)

SUBSCRIBED AND SWORN TO before me this 7th day of December, 1976

Joyce A. Hagermann
Notary Public.

My commission expires _____

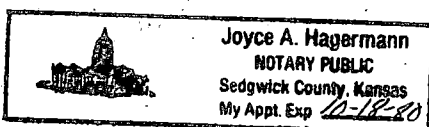

DRILLERS LOG

No. 1-16 Fagen

CASING RECORD:

8 5/8" @ 326'
w/200 sx cmt.

COMPANY: Graham-Michaelis Corporation

CONTRACTOR: Red Tiger Drilling Company

COMMENCED: November 18, 1976

COMPLETED: November 30, 1976

DESCRIPTION:

SE NW NW
Sec. 16-T24S-R23W
Hodgeman County, Kansas

TOTAL DEPTH: 4,765'

ELEVATION: 2,427' GR

<u>FORMATION</u>	<u>FROM</u>	<u>TO</u>
Post Rock & Shale	0	300
Shale	300	670
Shale & Shells	670	962
Anhydrite	962	983
Shale	983	1080
Sand	1080	1250
Shale	1250	2160
Shale & Lime Streaks	2160	2360
Lime & Shale	2360	2675
Lime	2675	2795
Lime & Shale	2795	4150
Lime	4150	4765
RTD		4765

RECEIVED
STATE CORPORATION COMMISSION

DEC 09 1976

CONSERVATION DIVISION
Wichita, Kansas

I certify that this is a true and correct copy of the above log to the best of my knowledge.

RED TIGER DRILLING COMPANY

Gloria Fawcett
Gloria Fawcett

Subscribed and sworn to before me this 7th day of December, 1976.

Joyce A. Hagermann
Notary Public

