


STATE OF KANSAS
STATE CORPORATION COMMISSION
CONSERVATION DIVISION
P. O. BOX 17027
WICHITA, KANSAS 67217

FORM CP-4

WELL PLUGGING RECORD

NORTH

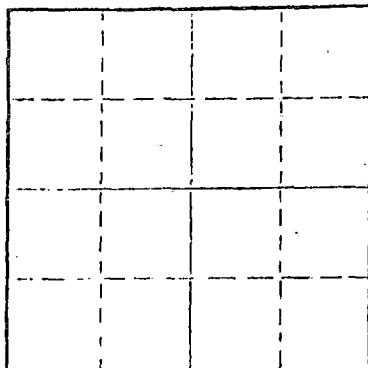

Locate well correctly on above
Section Plat

Hodgeman County, Sec. 15 Twp. 24 Rge. 23W(E) (W)
Location as "NE/CNW&SW" or footage from lines. C NE NE
Lease Owner. Donald C. Slawson
Lease Name. Nagel 'A' Well No. 1
Office Address. 408 120 Bldg. Wichita, Ks. 67202
Character of Well (completed as Oil, Gas or Dry Hole). Dry Hole
Date well completed Jan. 18 1976 19
Application for plugging filed Jan. 18, 1976 19
Application for plugging approved Jan. 18, 1976 19
Plugging commenced Jan. 18, 1976 19
Plugging completed Jan. 18, 1976 19
Reason for abandonment of well or producing formation. Dry Hole

If a producing well is abandoned, date of last production. 19
Was permission obtained from the Conservation Division or its agents before plugging was commenced? Yes

Name of Conservation Agent who supervised plugging of this well. Clarence Thomas 403 Davis Garden City, Ks.
Producing formation. Depth to top. Bottom. Total Depth of Well. 4750 Feet
Show depth and thickness of all water, oil and gas formations.

OIL, GAS OR WATER RECORDS

CASING RECORD

FORMATION	CONTENT	FROM	TO	SIZE	PUT IN	PULLED OUT
8 5/8"	311'				311'	

Describe in detail the manner in which the well was plugged, indicating where the mud fluid was placed and the method or methods used in introducing it into the hole. If cement or other plugs were used, state the character of same and depth placed, from feet to feet for each plug set.

1-29-76

RECEIVED

STATE CORPORATION COMMISSION

1st plug @ 900' w/45 sx

2nd plug @ 300' w/30 sx

3rd plug @ 40' w/15 sx

JAN 29 1976

CONSERVATION DIVISION

Wichita, Kansas

Name of Plugging Contractor. Slawson Drilling Company, Inc.
Address. 408 120 Bldg. Wichita, Ks. 67202

STATE OF Kansas COUNTY OF Sedgwick
James C. Remsberg

(employee of owner) or (owner/operator) of the above-described well, being first duly sworn on oath, says: That I have knowledge of the facts, statements, and matters herein contained and the log of the above-described well as filed and that the same are true and correct. So help me God.

(Signature)

James C. Remsberg

By Rene Stucky

SUBSCRIBED AND SWORN TO before me this 27th day of January 1976

My commission expires

Dolores B. Coady

Notary Public.

DOLORES B. COADY
STATE NOTARY PUBLIC
SEDGWICK COUNTY, KANSAS
Comm. Expires Mar. 7, 1976

WELL LOG

OPERATOR: Donald C. Slawson.
408 120 Bldg.
Wichita, Ks. 67202

LEASE: Nagel 'A' #1
C NE NE Sec. 15-24-23W
Hodgeman County, Kansas

CONTRACTOR: Slawson Drlg. Co., Inc.

COMMENCED: January 12, 1976

COMPLETED: January 18, 1976

CASING: Set 8 5/8" @ 311 w/250 sx

TOTAL DEPTH: 4750 feet

0 -	380	Surface Hole
380 -	995	Shale
995 -	1130	Sand
1130 -	1518	Shale & Shells
1518 -	2586	Shale & Shells
2586 -	4750	Lime & Shale
4750		RTD

STATE OF KANSAS)
COUNTY OF SEDGWICK) SS.

I, JAMES C. REMSBERG, Of the Slawson Drilling Company, Inc. upon oath state that the above and foregoing is a true and correct copy of the log of the #1 Nagel 'A' well.

RECEIVED
STATE CORPORATION COMMISSION

JAN 29 1976

CONSERVATION DIVISION
Wichita, Kansas

Rene Stucky
JAMES C. REMSBERG
By Rene Stucky

Subscribed and sworn to before me this 27th day of January, 1976

Dolores B. Coady
Dolores B. Coady, Notary Public

My Commission Expires:

DOLORES B. COADY
Notary Public
Sedgewick County, Kansas
Comm. Expires Jan 2, 1978
