


WELL PLUGGING RECORD

Give All Information Completely
Make Required Affidavit
Mail or Deliver Report to:
Conservation Division
State Corporation Commission
212 North Market, Insurance Bldg.
Wichita, Kansas

Reno County, Sec. 36 Twp. 23S Rge. 4 (E) (W) X

Location as "NE/CNW/SW" or footage from lines NE SW NE
Lease Owner Tom Armour
Lease Name Base Well No. 1
Office Address Box # 246, Hutchinson, Kansas
Character of Well (completed as Oil, Gas or Dry Hole) Dry Hole
Date well completed December 12, 19 63
Application for plugging filed December XXXX 12th. 19 63
Application for plugging approved 19
Plugging commenced December 12, 19 63
Plugging completed December 12, 19 63
Reason for abandonment of well or producing formation Hole Dry

NORTH

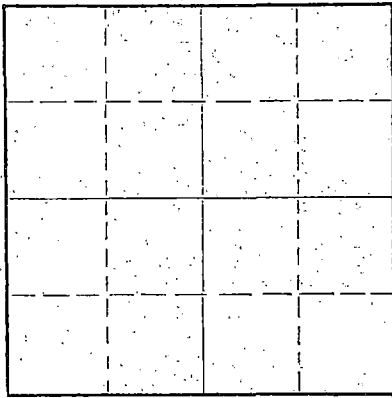

Locate well correctly on above Section Plat

If a producing well is abandoned, date of last production 19
Was permission obtained from the Conservation Division or its agents before plugging was commenced?

Name of Conservation Agent who supervised plugging of this well Gilbert J. Toman, Holyrood, Kansas
Producing formation Depth to top Bottom Total Depth of Well Feet
Show depth and thickness of all water, oil and gas formations.

OIL, GAS OR WATER RECORDS

CASING RECORD

FORMATION	CONTENT	FROM	TO	SIZE	PUT IN	PULLED OUT
Sand		0	133			
Shale		133	150			
Sand		150	164			
Shale & Shells		164	238	10 3/4"	238 ft.	None

Describe in detail the manner in which the well was plugged, indicating where the mud fluid was placed and the method or methods used in introducing it into the hole. If cement or other plugs were used, state the character of same and depth placed, from feet to feet for each plug set.

Filled hole with mud to 240 ft., set bridge at 240 ft. with wood plug, one sack of hulls and rock cemented with 20 sacks cement. Filled hole with mud to 35 ft. Set plug with Halliburton plug and hulls. Cemented with 8 sacks cement. Plugging completed at 1:00 P.M., December 12, 1963.

RECEIVED
STATE CORPORATION COMMISSION

DEC 19 1963

CONSERVATION DIVISION
Wichita, Kansas

(If additional description is necessary, use BACK of this sheet)

Name of Plugging Contractor Blackstone Drilling, Inc.
Address Box # 455, McPherson, Kansas

STATE OF Kansas, COUNTY OF Reno, ss.
Tom Armour (employee of owner) or (owner or operator) of the above-described well, being first duly sworn on oath, says: That I have knowledge of the facts, statements, and matters herein contained and the log of the above-described well as filed and that the same are true and correct. So help me God.

(Signature) Tom Armour
Box # 246, Hutchinson, Kansas (Address)


SUBSCRIBED AND SWORN to before me this 18th day of December, 19 63

My commission expires June 5, 1967

Erma E. Brown

Notary Public.



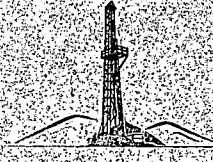

Blackstone Drilling, Inc.

Box 455 • 523 West Kansas • Phone CH 1-1250

McPHERSON • KANSAS
December 13, 1963

15-155-62080-0000

COMPANY: TOM ARMOUR
 CONTRACTOR: BLACKSTONE DRILLING, INC.
 FARM: BASE #1
 LOCATION: NE 1/4 SW 1/4 NE 1/4 of Sec. 36-23S-4W,
 Reno County, Kansas
 COMMENCED: December 3, 1963
 COMPLETED: December 12, 1963
 ELEVATION:

0	to	133	Sand
133	to	150	Shale
150	to	164	Sand
164	to	470	Shale & Shells
470	to	580	Lime & Shale
580	to	795	Shale & Shells
795	to	990	Lime & Shale
990	to	1085	Shale & Shells
1085	to	1400	Shale & Lime
1400	to	1910	Shale & Shells
1910	to	2540	Shale & Lime
2540	to	2665	Lime
2665	to	2741	Lime & Shale
2741	to	2944	Lime
2944	to	3157	Lime & Shale
3157	to	3270	Shale & Lime
3270	to	3340	Mississippi
		3340	T. D.

RECEIVED
 STATE CORPORATION COMMISSION
 DEC 19 1963
 CONSERVATION DIVISION
 Wichita, Kansas

Cut 15 1/4 in. hole to 238 ft. and run 240 ft. of 10 3/4 in. surface pipe, cemented on bottom at 238 ft. with 165 sacks cement and 5% chloride. Plug down at 4:00 P.M. December 3, 1963. Cut 7 7/8 in. hole to 3340 ft. Hole dry and abandoned. Filled hole with mud to 240 ft. Set bridge at 240 ft. with wood plug, one sack of hulls & rock cemented with 20 sacks cement. Filled hole with mud to 35 ft. set plug with halliburton plug and hulls. Cemented with 9 sacks cement. Plugging completed at 1:00 P.M., December 12, 1963 by Gilbert Toman, State Plugger, Holyrood, Kansas.

TOPS: Anhydrite - 470' Brown Lime - 2503' Lansing - 2535' Mississippi - 3262'

Measurements taken from K. B.

CERTIFICATE

I, H. J. Plouffe, President of Blackstone Drilling, Inc. do hereby certify that the above and foregoing is a true and correct copy of log on your Base #1 located in the NE SW NE of Sec. 36-23S-4W, Reno County, Kansas as reflected by the files of Blackstone Drilling, Inc.

H. J. Plouffe
 H. J. Plouffe, President

Subscribed and sworn to before me a Notary public in and for the said county of McPherson, Kansas this 13th day of December, 1963.

Ruth D. Gray
 Ruth Gray - Notary Public

My Commission Expires: December 18, 1965.