


WELL PLUGGING RECORD

Give All Information Completely
Make Required Affidavit
Mail or Deliver Report to:
Conservation Division
State Corporation Commission
211 No. Broadway
Wichita, Kansas

Kingman County, Sec. 21 Twp. 29 Rge. (E) 7 (W)

Location as "NE/CNW/SW" or footage from lines C NE/4 SW/4
Lease Owner Walters Drilling Co.
Lease Name Birkenbaugh Well No. 1
Office Address 510 Orpheum Building, Wichita 2, Kansas
Character of Well (completed as Oil, Gas or Dry Hole) Dry Hole
Date well completed April 23, 1961 19
Application for plugging filed April 26, 1961 19
Application for plugging approved April 24, 1961 19
Plugging commenced April 23, 1961 19
Plugging completed April 23, 1961 19
Reason for abandonment of well or producing formation _____

NORTH

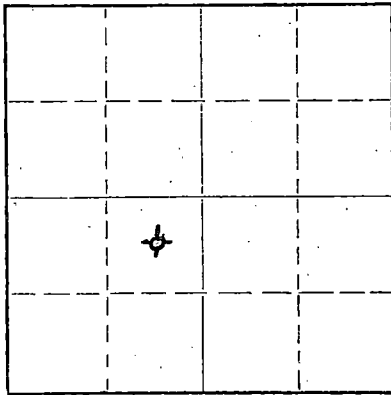

Locate well correctly on above Section Plat

If a producing well is abandoned, date of last production _____ 19
Was permission obtained from the Conservation Division or its agents before plugging was commenced? Verbal approval from Fred Hampel on April 23, 1961

Name of Conservation Agent who supervised plugging of this well Fred Hampel
Producing formation _____ Depth to top _____ Bottom _____ Total Depth of Well _____ Feet
Show depth and thickness of all water, oil and gas formations.

OIL, GAS OR WATER RECORDS

CASING RECORD

FORMATION	CONTENT	FROM	TO	SIZE	PUT IN	PULLED OUT
				8 5/8"	217.46	-0-

Describe in detail the manner in which the well was plugged, indicating where the mud fluid was placed and the method or methods used in introducing it into the hole. If cement or other plugs were used, state the character of same and depth placed, from _____ feet to _____ feet for each plug set.

Set first plug @ 210' w/hulls and 15 sx cmt.
Set top plug @ 35' w/hulls and 10 sx cmt.

RECEIVED
STATE CORPORATION COMMISSION
APR 27 1961
CONSERVATION DIVISION
Wichita, Kansas
04-27-61

(If additional description is necessary, use BACK of this sheet)

Name of Plugging Contractor Walters Drilling Co.
Address 510 Orpheum Building, Wichita 2, Kansas

STATE OF KANSAS, COUNTY OF SEDGWICK, ss.
Robert F. Walters (owner or operator) of the above-described well, being first duly sworn on oath, says: That I have knowledge of the facts, statements, and matters herein contained and the log of the above-described well as filed and that the same are true and correct. So help me God.

(Signature) Robert F. Walters
Robert F. Walters
April 26, 1961
(Address)

SUBSCRIBED AND SWORN TO before me this 26 day of April, 1961

My commission expires January 4, 1964
R. L. Abel
R. L. Abel Notary Public.



BIRKENBAUGH #1

LOCATION: C NE/4 SW/4 Sec. 21-29S-7W
Kingman County, Kansas

DATE SPUDDED: 4/13/61
ROTARY COMPLETION: 4/23/61

OPERATOR: LARIO OIL & GAS COMPANY

ELEVATION: 1559 GL
1562 DF
1564 KB

CONTRACTOR: WALTERS DRILLING CO.

SURFACE CASING: 8-5/8" casing set @ 224'
with 175 sacks cement

OIL STRING: None

L O G

(Figures indicate bottom of formation)

Red Rock	0-500'
Shale & Shell	1,225'
Lime & Shale	1,560'
Lime	1,750'
Lime & Shale	3,050'
Lime, Shale & Sand	3,195'
Lime & Shale	3,260'
Sand & Shale	3,355'
Lime & Shale	3,397'
Lime	3,867'
Lime & Shale	4,164'
Lime	4,204'
Total Depth	4,204'

RECEIVED
STATE CORPORATION COMMISSION
APR 27 1961
CONSERVATION DIVISION
Wichita, Kansas

The undersigned, Robert F. Walters, hereby certifies that the above log is a true and correct log of the formations encountered in drilling the above noted well as reflected by the Daily Drilling Reports.

WALTERS DRILLING CO.

by



ROBERT F. WALTERS, Partner

Subscribed and sworn to before me
this 26th day of April, 1961


Notary Public

My commission expires January 4, 1964