

STATE OF KANSAS  
STATE CORPORATION COMMISSION

WELL PLUGGING RECORD

SEP 23 1981

09-23-81

CONSERVATION DIVISION  
Wichita, Kansas

Give All Information Completely  
Make Required Affidavit  
Mail or Deliver Report to  
Conservation Division  
State Corporation Comm.  
245 North Water  
Wichita, KS 67202

Rice County, Sec. 23 Twp. 20S Rge 9W  
Location as "NE/CNW $\frac{1}{4}$ SW $\frac{1}{4}$ " or footage from lines  
C E/2 SW/4

Lease Owner Lebsack Oil Production, Inc.

Lease Name Smisor Well No. 1

Office Address P. O. Box 489, Hays, Kansas 67601

Character of Well (Completed as Oil, Gas or Dry Hole)  
Dry Hole

Date Well completed September 20, 1981

Application for plugging filed September 20, 1981

Application for plugging approved September 20, 1981

Plugging commenced 6:15 PM September 20, 1981

Plugging completed 7:00 PM September 20, 1981

Reason for abandonment of well or producing formation  
Dry Hole


If a producing well is abandoned, date of last production  
19

Was permission obtained from the Conservation Division or  
its agents before plugging was commenced? Yes

Name of Conservation Agent who supervised plugging of this well Gilbert Toman

Producing formation Depth to top Bottom Total Depth of Well 3400'

Show depth and thickness of all water, oil and gas formations.

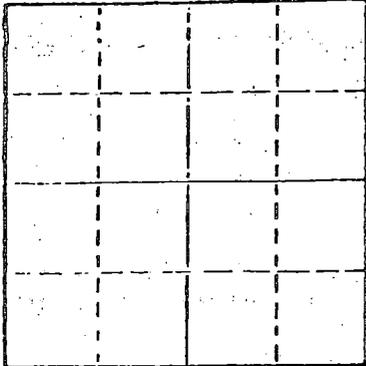

Locate well correctly on above  
Section Plat

OIL, GAS OR WATER RECORDS

CASING RECORD

FORMATION	CONTENT	FROM	TO	SIZE	PUT IN	PULLED OUT
				8 5/8"	214'	None

Describe in detail the manner in which the well was plugged, indicating where the mud fluid was placed and the method or methods used in introducing it into the hold. If cement or other plugs were used, state the character of same and depth placed, from feet to feet for each plug set.

Filled hole with heavy mud.  
Heavy mud to 310' with 50 sacks 50/50 Pozmix  
with 2% gel and 3% cc through open ended drill  
pipe at 310'. Heavy mud to 40' with Howco plug  
and 1/2 sack hulls with solid bridge at 40',  
10 sacks to surface and 10 sacks in rathole.

(If additional description is necessary, use BACK of this sheet)

Name of Plugging Contractor Sterling Drilling Company, P. O. Box 129, Sterling, Kansas 67579

STATE OF KANSAS COUNTY OF RICE, ss.  
F. A. Wuellner (employee of owner) or (owner or operator)

of the above-described well, being first duly sworn on oath, says: That I have knowledge of the facts, statements, and matters herein contained and the log of the above-described well as filed and that the same are true and correct. So help me God.

STERLING DRILLING COMPANY  
(Signature) *F. A. Wuellner*  
F. A. Wuellner, Secretary  
P. O. Box 129, Sterling, Kansas 67579  
(Address)

SUBSCRIBED AND SWORN TO before me this 23rd day of September, 1981.



*Agnes D. Wurst*  
Agnes D. Wurst, Notary Public.

My commission expires

STERLING DRILLING COMPANY  
P. O. Box 129  
Sterling, Kansas 67579

RECEIVED  
STATE CORPORATION COMMISSION

SEP 25 1981

CONSERVATION DIVISION  
Wichita, Kansas

WELL LOG ----- SMISOR #1  
Located: C E/2 SW/4, Section 23-20S-9W, Rice County, Kansas

OWNER: Lebsack Oil Production, Inc.  
ROTARY DRILLING CONTRACTOR: Sterling Drilling Company

COMMENCED: September 14, 1981  
COMPLETED: September 20, 1981

TOTAL DEPTH: 3400'

LOG

CASING RECORD

0 - 218 Sand and Clay  
218 - 1092 Shale  
1092 - 1220 Shale and Lime Stringers  
1220 - 2930 Lime and Shale  
2930 - 3381 Lime  
3381 - 3400 Arbuckle

Ran 5 joints 8 5/8", 24# casing. 203.29'  
pipe set at 214' K.B. Cemented with 225  
sacks 60/40 Pozmix with 3% cc. Plug  
down at 9:30 PM, 9-14-81, by Howco.

Plugged.

Deviation Surveys: 1/2° at 1500'  
1/2° at 3400'