

CARD MUST BE TYPED

State of Kansas  
**NOTICE OF INTENTION TO DRILL**  
(see rules on reverse side)

CARD MUST BE SIGNED

Starting Date: 9 12 84  
month day year

API Number 15- 095-21,487-000

**OPERATOR:** License # 5123  
Name Pickrell Drilling Company  
Address 110 N. Market, Suite 205  
City/State/Zip Wichita, Kansas 67202  
Contact Person Jay McNeil  
Phone 262-8427

NW NW SE Sec 8 Twp 30 S, Rge 6  
(location)  
2300 Ft North from Southeast Corner of Section  
2310 Ft West from Southeast Corner of Section  
(Note: Locate well on Section Plat on reverse side)

**CONTRACTOR:** License # 5123  
Name Pickrell Drilling Company  
City/State Wichita, Kansas

Nearest lease or unit boundary line 330' feet.  
County Kingman  
Lease Name Messenger 'H' Well# 1  
Domestic well within 330 feet:  yes  no  
Municipal well within one mile:  yes  no

**Well Drilled For:** **Well Class:** **Type Equipment:**  
 Oil  Swd  Infield  Mud Rotary  
 Gas  Inj  Pool Ext.  Air Rotary  
 OWWO  Expl  Wildcat  Cable

Depth to Bottom of fresh water 60 feet  
Lowest usable water formation Nippewalla  
Depth to Bottom of usable water 200 feet  
Surface pipe by Alternate: 1  2   
Surface pipe to be set 200+ feet  
Conductor pipe if any required feet  
Ground surface elevation 1397 feet MSL  
This Authorization Expires 3-4-85  
Approved By [Signature]

If OWWO: old well info as follows:  
Operator  
Well Name  
Comp Date Old Total Depth  
Projected Total Depth 4550 feet  
Projected Formation at TD Simpson Sand  
Expected Producing Formations KC, Miss, Simpson

I certify that we will comply with K.S.A. 55-101, et seq., plus eventually plugging hole to K.C.C. specifications.

Date 9-4-84 Signature of Operator or Agent [Signature] Title Jay C. McNeil-Chief Geol.  
MHC/KOHE 9/4/84

**Must be filed with the K.C.C. five (5) days prior to commencing well  
This card void if drilling not started within six (6) months of date received by K.C.C.**

RECEIVED  
STATE CORPORATION COMMISSION

8-3-84  
AUG 3 1984


CONSERVATION DIVISION  
Wichita, Kansas

**Important procedures to follow:**

1. Notify District office before setting surface casing.
2. Set surface casing by circulating cement to the top.
3. File completion forms ACO-1 with K.C.C. within 90 days of well completion, following instructions on ACO-1, side 1, and including copies of wireline logs.
4. Notify District office 48 hours prior to old well workover or re-entry.
5. Prior to plugging, prepare a plugging plan, then obtain agreement from the appropriate district office for an approved plugging plan.
6. Submit plugging report (CP-4) to K.C.C. after plugging is completed.
7. Obtain an approved injection docket number before disposing of salt water.
8. Notify K.C.C. within 10 days when injection commences or terminates.
9. If an alternate 2 completion, cement in the production pipe from below any usable water to surface within 120 days of spud date.

**A Regular Section of Land**

1 Mile = 5,280 Ft.

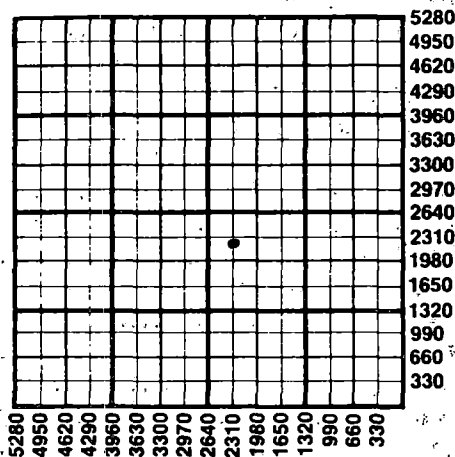

State Corporation Commission of Kansas  
Conservation Division  
200 Colorado Derby Building  
Wichita, Kansas 67202  
(316) 263-3238