


STATE OF KANSAS
STATE CORPORATION COMMISSION

WELL PLUGGING RECORD

Give All Information Completely
Make Required Affidavit
Make Deliver Report to:
Conservation Division
State Corporation Commission
211 No. Broadway
Wichita, Kansas

Kingman County. Sec. 30 Twp. 29 Rge. (E) 7 (W)
Location as "NE/CNW/SE/SW" or footage from lines NW 1/4 SE 1/4 NE 1/4
Lease Owner Drilling and Exploration Company, Inc.
Lease Name Oak Well No. 1
Office Address 811 Union Center, Wichita, Kansas
Character of Well (completed as Oil, Gas or Dry Hole) Dry hole
Date well completed April 25, 1960
Application for plugging filed April 25, 1960
Application for plugging approved April 25, 1960
Plugging commenced April 25, 1960
Plugging completed April 25, 1960
Reason for abandonment of well or producing formation Dry

NORTH

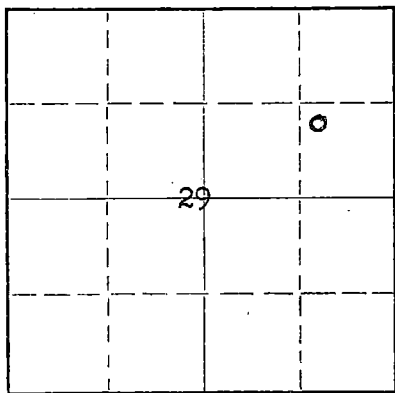

Locate well correctly on above
Section Plat

If a producing well is abandoned, date of last production 19
Was permission obtained from the Conservation Division or its agents before plugging was commenced? Yes

Name of Conservation Agent who supervised plugging of this well Fred Hampel
Producing formation None Depth to top Bottom Total Depth of Well 4245 Feet
Show depth and thickness of all water, oil and gas formations.

OIL, GAS OR WATER RECORDS

CASING RECORD

FORMATION	CONTENT	FROM	TO	SIZE	PUT IN	PULLED OUT
Surface Sand & Gravel		0	286'	8-5/8"	284'	None

Describe in detail the manner in which the well was plugged, indicating where the mud fluid was placed and the method or methods used in introducing it into the hole. If cement or other plugs were used, state the character of same and depth placed, from feet to feet for each plug set.

Filled hole to 260' with rotary mud. Pushed Halliburton plug to 260' w/drill pipe. Pumped 18 sack plug through drill pipe. Plug from 260' to 210'. Filled to 35' with rotary mud. Pushed Halliburton plug to 35'. Filled to surface w/cement.

Plugged mouse and rat hole w/cement.

RECEIVED
STATE CORPORATION COMMISSION
APR 29 1960
CONSERVATION DIVISION
Wichita, Kansas
RCMO 04-29-60

(If additional description is necessary, use BACK of this sheet)
Name of Plugging Contractor Mack Oil Company and Halliburton
Address Duncan, Oklahoma

STATE OF Kansas, COUNTY OF Sedgwick, ss.
Karl A. Peterson (employee of owner) or (owner or operator) of the above-described well, being first duly sworn on oath, says: That I have knowledge of the facts, statements, and matters herein contained and the log of the above-described well as filed and that the same are true and correct. So help me God.

(Signature) Karl A. Peterson
811 Union Center, Wichita, Kansas
(Address)

SUBSCRIBED AND SWORN TO before me this 27th day of April, 1960

My commission expires May 6, 1961
Notary Public.



DRILLING AND EXPLORATION COMPANY, INC.

Dallas, Texas

DRILLERS WELL LOG

Oak #1

Commenced R.D.: 4-14-60
Completed R.D.: 4-26-60
Total Depth: 4242'

NW SE NE Sec. 30-29S-7W
Kingman County, Kansas
Elevation: 1531 R.B.
Initial Production: D&A
Contractor: Mack Oil Co.

Casing Record: 277' of 8-5/8" at 284' OD surface casing

<u>STRATA</u>	<u>DEPTH</u>
Sand & clay	0' - 250'
Shale	250' - 286'
Red beds	286' - 500'
Shale	500' - 1332'
Anhydrite	1332' - 1350'
Lime	1350' - 1875'
Lime & Shale	1875' - 2020'
Shale & Shells	2020' - 2111'
Shale	2111' - 2319'
Shale & Shells	2319' - 2853'
Lime & Shale	2853' - 3177'
Lime	3177' - 3253'
Sand	3253' - 3352'
Lime	3352' - 4000'
Lime & Shale	4000' - 4110'
Lime	4110' - 4151'
Chert & lime	4151' - 4242'

RECEIVED
STATE CORPORATION COMMISSION

APR 29 1960
CONSERVATION DIVISION
Wichita, Kansas

I hereby certify that the above is a true and correct log of said well as reflected by the daily drilling reports.

MACK OIL COMPANY

By Harold L. Steincamp

Signed and sworn to in my presence this 28th day of April, 1960, by Harold L. Steincamp, a representative of Mack Oil Company.

Elizabeth K. Sutton
Elizabeth K. Sutton
Notary Public

My Commission Expires: May 6, 1961