


STATE OF KANSAS
STATE CORPORATION COMMISSION

Give All Information Completely
Make Required Affidavit
Mail or Deliver Report to:
Conservation Division
State Corporation Commission
212 No. Market
Wichita, Kansas

15-095-19038-0000 Form CP-4
WELL PLUGGING RECORD

NORTH

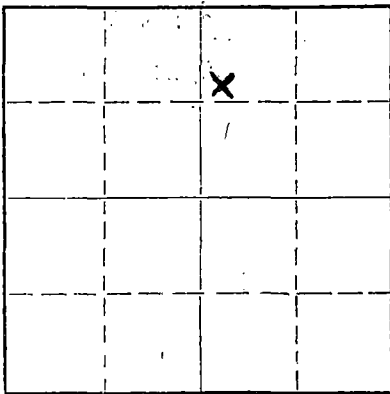

Locate well correctly on above
Section Plat

Kingman County, Sec 32 Twp. 29 Rge. 7 (E) W (W)
Location as "NE/CNW/SW" or footage from lines SW NW NE
Lease Owner Pickrell Drilling Co. Wichita, Kansas
Lease Name Brand Well No. #3
Office Address 705 Fourth National Bank Building
Character of Well (completed as Oil, Gas or Dry Hole) Oil
Date well completed March 28 1961
Application for plugging filed January 19 70
Application for plugging approved January 19 70
Plugging commenced March 2 19 70
Plugging completed March 7 19 70
Reason for abandonment of well or producing formation Depleted

If a producing well is abandoned, date of last production May 19 67
Was permission obtained from the Conservation Division or its agents before plugging was commenced? Yes

Name of Conservation Agent who supervised plugging of this well Russell Biberstein
Producing formation Mississippi Depth to top 4089 Bottom Total Depth of Well 4240 Feet
Show depth and thickness of all water, oil and gas formations.

OIL, GAS OR WATER RECORDS

CASING RECORD

| FORMATION | CONTENT | FROM | TO | SIZE | PUT IN | PULLED OUT |
|-----------|---------|------|----|-------|--------|------------|
| | | | | 8 5/8 | 236 | None |
| | | | | 5 1/2 | 4237 | 3457 |

RECEIVED
STATE CORPORATION COMMISSION
MAY 5 1970
CONSERVATION DIVISION
Wichita, Kansas
Per 05-05-70

Describe in detail the manner in which the well was plugged, indicating where the mud fluid was placed and the method or methods used in introducing it into the hole. If cement or other plugs were used, state the character of same and depth placed, from feet to feet for each plug set.

March 2, 1970 Plugged off bottom. Dumped sand to 4050'. Mixed and dumped 5 sx of cement to 4010'.

March 7, 1970 Plugged off top. Mud to 230', 10' rock bridge from 220' to 230'. Mixed and dumped 25 sx of cement. Mud to 40'. 10' rock bridge from 40' to 30'. Mixed and dumped 10 sx of cement from 30' to base of cellar.

(If additional description is necessary, use BACK of this sheet)

Name of Plugging Contractor Russ Casing Pulling, Inc.
Address P. O. Box 1082 Great Bend, Kansas 67530

STATE OF Kansas, COUNTY OF Sedgwick, ss.
Dale M. Robinson (employee of owner) or (owner or operator) of the above-described well, being first duly sworn on oath, says: That I have knowledge of the facts, statements, and matters herein contained and the log of the above-described well as filed and that the same are true and correct. So help me God.

(Signature) Dale M. Robinson
705 Fourth National Bank Bldg, Wichita, Kansas
(Address)

SUBSCRIBED AND SWORN to before me this 1st day of May, 19 70.

My commission expires January 19, 1973



Esther Lamone
Notary Public.

File Copy
ROTARY DRILLING LOG

COMPANY: Pickrell Drilling Company
705 Fourth National Bank Building
Wichita 2, Kansas

Rotary Drilling Commenced 3-3-61

Rotary Drilling Completed 3-16-61

LOCATION: BRAND #3 - SW NW NE 32-29S-7W, Kingman County, Kansas

CONTRACTOR: **PICKRELL DRILLING COMPANY**
Wichita, Kansas

CASING RECORD: Ran 6 jts. 20# 8 5/8" Surface Casing. Set at 236' w/165 sks. Circ.
Ran 136 jts. 5 1/2" Smls. Csg. Set at 4237' w/110 sks.

LOG

(Figures indicate bottom of formation — measurements from top of rotary bushing.)

| | | |
|-------|-------------------|------------------------------|
| 236' | Red rock | <u>Circulate for Samples</u> |
| 1115' | Red rock, shale | |
| 1365' | Lime, shale | 4100' |
| 1700' | Lime | 4111' |
| 3065' | Lime, shale | 4130' |
| 3367' | Lime, shale, sand | 4150' |
| 3813' | Lime | 4160' |
| 4100' | Lime, shale | 4183' |
| 4240' | Miss. T.D. | 4190' |
| | | 4200' |
| | | 4210' |
| | | 4220' |
| | | 4240' |

RECEIVED
STATE CORPORATION COMMISSION
FEB 26 1970
CONSERVATION DIVISION
Wichita, Kansas

Slope Test

2949'

S.L.M.

3440'

The undersigned, C. W. Sebitts, Attorney-in-Fact for PICKRELL DRILLING COMPANY, hereby certifies in behalf of said Company, that the above is a true and correct log of the formation encountered in drilling the above well as reflected by the Daily Drilling Reports.

PICKRELL DRILLING COMPANY

By *C. W. Sebitts*
Attorney-in-Fact

STATE OF KANSAS }
COUNTY OF SEDGWICK } ss.:

On this 28th day of March, 1961, before me the undersigned, a Notary Public, in and for

the County and State aforesaid, personally appeared C. W. Sebitts, to me known to be the identical person who subscribed the name of PICKRELL DRILLING COMPANY to the foregoing instrument as its Attorney-in-Fact and acknowledged to me that he executed the same as his free and voluntary act and deed, and as the free and voluntary act and deed of such company, for the uses and purposes therein set forth.

Given under my hand and seal of office the day and year last above written.

My commission expires: March 7, 1964

Marilyn A. Davis
Notary Public
Marilyn A. Davis