

FEB 16 1971

CONSERVATION DIVISION
Wichita, Kansas

Form CP-4

15-095-00736-0000

WELL PLUGGING RECORD

STATE OF KANSAS
STATE CORPORATION COMMISSION

Give All Information Completely
Make Required Affidavit
Mail or Deliver Report to:
Conservation Division
State Corporation Commission
212 No. Market,
Wichita, Kansas 67202

Kingman County, Sec. 33 Twp. 29 Rge. 7 (E)W (W)

Location as "NE/CNW/SW" or footage from lines NE NE NE

Lease Owner Pickrell Drlg. Co.; Wichita, Ks. 67202

Lease Name Birkenbaugh 'B' Well No. # 1

Office Address 705 Fourth National Bank Bldg. Wichita, Kansas

Character of Well (completed as Oil, Gas or Dry Hole) OIL

Date well completed June 1 1958

Application for plugging filed January 8 1971

Application for plugging approved January 8 1971


Plugging commenced January 11 1971

Plugging completed January 13 1971

Reason for abandonment of well or producing formation Depleted

If a producing well is abandoned, date of last production November 1 1970

Was permission obtained from the Conservation Division or its agents before plugging was commenced? Yes

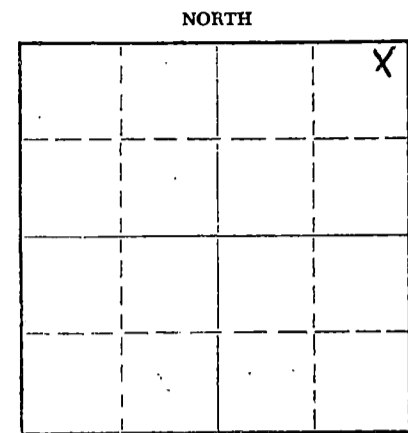

Locate well correctly on above Section Plat

Name of Conservation Agent who supervised plugging of this well Russell Biberstein

Producing formation Mississippian Depth to top 416 Bottom 4240 Total Depth of Well 4240 Feet

Show depth and thickness of all water, oil and gas formations.

OIL, GAS OR WATER RECORDS

CASING RECORD

FORMATION	CONTENT	FROM	TO	SIZE	PUT IN	PULLED OUT
				8 5/8	250	None
				4 1/2	4233	309

Describe in detail the manner in which the well was plugged, indicating where the mud fluid was placed and the method or methods used in introducing it into the hole. If cement or other plugs were used, state the character of same and depth placed, from _____ feet to _____ feet for each plug set.

January 11, 1971 Plugged off bottom. Dumped sand to 4125'. Mixed and dumped 4 sx of cement to 4075'.

January 13, 1971 Plugged off top. Set 10' rock bridge from 240' to 230'. Filled 8 5/8" surface casing, from 230' to base of cellar, with 4 yds. of 3000 lb. P.S.I. ready mix concrete.

(If additional description is necessary, use BACK of this sheet)
Name of Plugging Contractor RUSS CASING PULLING, INC.
Address P. O. Box 1082 Great Bend, Kansas 67530

STATE OF Kansas, COUNTY OF Sedgwick, ss.
Dale M. Robinson (employee of owner) or (owner or operator) of the above-described well, being first duly sworn on oath, says: That I have knowledge of the facts, statements, and matters herein contained and the log of the above-described well as filed and that the same are true and correct. So help me God.

(Signature) Dale M. Robinson
705 Fourth National Bank Bldg., Wichita, Kansas (Address)



SUBSCRIBED AND SWORN to before me this 15th day of February, 1971.
Esther Lamone Notary Public.
My commission expires January 19, 1973

ROTARY- DRILLING LOG

COMPANY: Pickrell Drilling Company

Rotary Drilling Commenced 5/20/58

Rotary Drilling Completed 6/3/58

LOCATION: NE NE NE Sec. 33-39-7W
Kingman County, Kansas

CONTRACTOR: Birkenbaugh "B" #1
PICKRELL DRILLING COMPANY
Wichita, Kansas

JAN 8 1971

CASING RECORD: 240' (6jts) 8 5/8" 22.7# Armo Spralweld casing cemented with 115 sacks cement. Cement circulated.

4 1/2" 9.5# J-55 Smls. Casing set at 4233' cemented with 100 sacks cement with 2% gel.

LOG

(Figures indicate bottom of formation — measurements from top of rotary bushing.)

Red Rock, Shale & Shells	975'	Circ. for samples at 4125'
Lime & Shale	1165'	4158'
Lime	1615'	4220'
Lime, Sandy	1785'	4240'
Lime	1945'	
Lime & Shale	2940'	
Lime	3100'	
Lime & Shale	3215'	
Shale	3260'	
Shale & Sand	3345'	
Lime	3500'	
Lime & Shale	3562'	
Lime	3805'	
Lime & Shale	4123'	
Mississippi	4240' T.D.	

S.L.M. at 1500 - O.K.
2500 - O.K.
3500 - O.K.

Slope Test at 1500 0° off
2500 0° off
3500 0° off

The undersigned, C. W. Sebitts, Attorney-in-Fact for PICKRELL DRILLING COMPANY, hereby certifies in behalf of said Company, that the above is a true and correct log of the formation encountered in drilling the above well as reflected by the Daily Drilling Reports.

PICKRELL DRILLING COMPANY

By C. W. Sebitts
Attorney-in-Fact

STATE OF KANSAS }
COUNTY OF SEDGWICK } ss.:

On this 5th day of June, 19 58, before me the undersigned, a Notary Public, in and for

the County and State aforesaid, personally appeared C. W. Sebitts, to me known to be the identical person who subscribed the name of PICKRELL DRILLING COMPANY to the foregoing instrument as its Attorney-in-Fact and acknowledged to me that he executed the same as his free and voluntary act and deed, and as the free and voluntary act and deed of such company, for the uses and purposes therein set forth.

Given under my hand and seal of office the day and year last above written.

My commission expires: October 13, 1960

Lorraine M. Johnson
Notary Public