


Give All Information Completely
Make Required Affidavit
Mail or Deliver Report to:
Conservation Division
State Corporation Commission
211 No. Broadway
Wichita, Kansas

R

WELL PLUGGING RECORD

NORTH

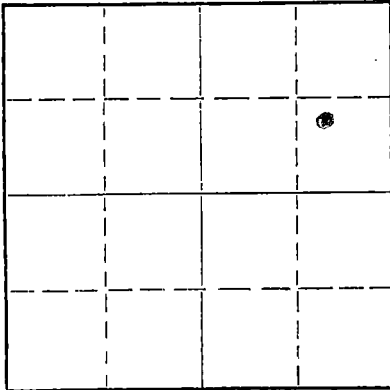

Locate well correctly on above Section Plat

Kingman County, Sec. 33 Twp. 29S Rge. 7 / (E) / (W)
Location as "NE/CNWxSWx" or footage from lines NW SE NE
Lease Owner Pickerell Drilling Co.
Lease Name Birkenbaugh "B" Well No. 3
Office Address 705 Fourth Nat'l Bank Bldg., Wichita, Kansas
Character of Well (completed as Oil, Gas or Dry Hole) oil
Date well completed 6-11 19 59
Application for plugging filed 6-27 19 63
Application for plugging approved 19
Plugging commenced 7-01 19 63
Plugging completed 7-02 19 63
Reason for abandonment of well or producing formation depleted

If a producing well is abandoned, date of last production 19
Was permission obtained from the Conservation Division or its agents before plugging was commenced? ~~NO~~ YES

Name of Conservation Agent who supervised plugging of this well Archie V. Elving
Producing formation _____ Depth to top _____ Bottom _____ Total Depth of Well 4245 Feet
Show depth and thickness of all water, oil and gas formations.

OIL, GAS OR WATER RECORDS

CASING RECORD

FORMATION	CONTENT	FROM	TO	SIZE	PUT IN	PULLED OUT
				8 5/8	248	none
				5 1/2	4269	3634.20

Describe in detail the manner in which the well was plugged, indicating where the mud fluid was placed and the method or methods used in introducing it into the hole. If cement or other plugs were used, state the character of same and depth placed, from _____ feet to _____ feet for each plug set.

Dumped sand back to 4180 feet and dumped 5 sacks cement with bailer.

Set 10 foot rock bridge at 240 feet and dumped 20 sacks cement. Mud hole to 40 feet, set 10 foot rock bridge and dumped 10 sacks cement.

RECEIVED
STATE CORPORATION COMMISSION

07-12-63 JUL 12 1963

CONSERVATION DIVISION
Wichita, Kansas

(If additional description is necessary, use BACK of this sheet)
Name of Plugging Contractor Kent Well Servicing Company
Address Box 470, El Dorado, Kansas

STATE OF Kansas, COUNTY OF Butler, ss.

(employee of owner) or (owner or operator) of the above-described well, being first duly sworn on oath, says: That I have knowledge of the facts, statements, and matters herein contained and the log of the above-described well as filed and that the same are true and correct. So help me God.

(Signature) Mary Payne

(Address)

SUBSCRIBED AND SWORN TO before me this 9th day of July, 19 63

Erskine E. Phillips

Notary Public.

My commission expires

June 18, 1967



File Copy
ROTARY DRILLING LOG

COMPANY: Pickrell Drilling Company

Rotary Drilling Commenced 5/28/59

LOCATION: NW SW NE Sec. 33-29-7
Kingman County, Kansas
Birkenbaugh "B" #3

Rotary Drilling Completed 6/11/59

CONTRACTOR: PICKRELL DRILLING COMPANY
Wichita, Kansas

CASING RECORD: 248' 8 5/8" 22.7# Armco Spiralweld Casing
4269' 14' 5 1/2" J-55 Casing, cemented with 100 sacks cement.

LOG

(Figures indicate bottom of formation — measurements from top of rotary bushing.)

Red Rock	475'	Circulate for samples:
Shale and Shells	910'	4119'
Lime and Shale	2170'	4151'
Sable and Sand, and Lime	2260'	4190'
Shale and Sand	2400'	4198'
Lime and Shale	2815'	4220'
Lime Shale, and Sand	3375'	4235'
Sable and Lime	3438'	4245'
Lime	3840'	4270'
Lime and Shale	4130'	
Mississippi	4270' T.D.	

S.L.M. @ 2000' - OK
3000' - OK
4000' - OK
Slope Test 2000' - 0° off
3000' - 0° off
4000' - 0° off

RECEIVED
STATE CORPORATION COMMISSION
JUL 12 1963
CONSERVATION DIVISION
Wichita, Kansas

The undersigned, C.W. Sebitts, Attorney-in-Fact for PICKRELL DRILLING COMPANY, hereby certifies in behalf of said Company, that the above is a true and correct log of the formation encountered in drilling the above well as reflected by the Daily Drilling Reports.

PICKRELL DRILLING COMPANY
By *C.W. Sebitts*
Attorney-in-Fact

STATE OF KANSAS }
COUNTY OF SEDGWICK } ss.:

On this 18 day of June, 19 59, before me the undersigned, a Notary Public, in and for

the County and State aforesaid, personally appeared C.W. Sebitts, to me known to be the identical person who subscribed the name of PICKRELL DRILLING COMPANY to the foregoing instrument as its Attorney-in-Fact and acknowledged to me that he executed the same as his free and voluntary act and deed, and as the free and voluntary act and deed of such company, for the uses and purposes therein set forth.

Given under my hand and seal of office the day and year last above written.

My commission expires: August 14, 1961

Ruth M. Sullivan
Notary Public
Ruth M. Sullivan