


Give All Information Completely
Make Required Affidavit
Mail or Deliver Report to:
Conservation Division
State Corporation Commission
800 Biting Building
Wichita, Kansas

NORTH

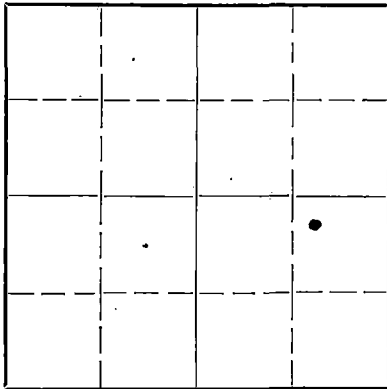

Locate well correctly on above Section Plat

Barber County, Sec. 27 Twp. 30S. Rge. 15 (E) W. (W)
Location as "NE $\frac{1}{4}$ NW $\frac{1}{4}$ SW $\frac{1}{4}$ " or footage from lines NW NE SE
Lease Owner Great Lakes Carbon Corporation
Lease Name Massey "B" Well No. 1
Office Address 501 Petroleum Building, Wichita, 2, Kansas
Character of Well (completed as Oil, Gas or Dry Hole) Dry Hole
Date well completed 11-2 1943
Application for plugging filed 11-2 1943
Application for plugging approved 11-2 1943
Plugging commenced 3-17 1944
Plugging completed 3-20 1944
Reason for abandonment of well or producing formation Dry Hole

If a producing well is abandoned, date of last production 19
Was permission obtained from the Conservation Division or its agents before plugging was commenced? yes

Name of Conservation Agent who supervised plugging of this well C. T. Alexander
Producing formation Massey Zone Depth to top 4310 Bottom 4378 Total Depth of Well 4368 Feet
Show depth and thickness of all water, oil and gas formations.

OIL, GAS OR WATER RECORDS

CASING RECORD

Formation	Content	From	To	Size	Put In	Pulled Out
Massey Zone	Dry	4310	4318	8-5/8"	769	None
				5-1/2"	4310	3400

Describe in detail the manner in which the well was plugged, indicating where the mud fluid was placed and the method or methods used in introducing it into the hold. If cement or other plugs were used, state the character of same and depth placed, from feet to feet for each plug set.

Cement 4368 to 4178


Mud 4178 to 300

Bridge 300

Cement 300 to 280

Mud 280 to 20

Cement 20 to 5

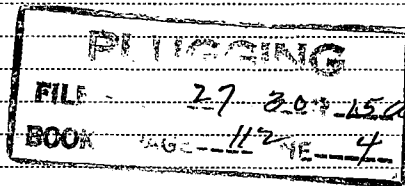

Recd 4-3-44

Plugged to specifications set out by C. T. Alexander

(If additional description is necessary, use BACK of this sheet)

Correspondence regarding this well should be addressed to Great Lakes Carbon Corporation
Address 501 Petroleum Building, Wichita, 2, Kansas

STATE OF Kansas COUNTY OF Sedgwick ss.
W. J. Coppingen (employee of owner) or (owner or operator) of the above-described well,
being first duly sworn on oath, says: That I have knowledge of the facts, statements, and matters herein contained and the log of the above-described well as filed and that the same are true and correct. So help me God.

(Signature) W. J. Coppingen, Mgr. Oil & Gas Division
(Address)

SUBSCRIBED AND SWORN TO before me this 1st day of April, 1944

Verdina B. Rutledge
Notary Public.

My commission expires March 15, 1948

GREAT LAKES SALINE CORPORATION
No. 1 Massey "B"

sect. 27, Twp. 30S Rge. 15W
NW 1/4 SE Barber County

Comm. Date: Sept. 18, 1945

I. P. DRY

Comp. Date: November 11, 1945

Coring Records:
8 5/8" 769'
5 1/2" 4510'

Red Rock and Shells	650
Shale and Shells	769
Red Rock	1045
Salt	1410
Shale and Shales	1510
Lime and shale	1850
Lime	2050
Sandy Lime	2090
Sand lime and shale	2200
Shale and shells	2260
Sandy lime	2335
Shale and shells	2575
Lime and shale	2715
Shale and shells	2810
Shale and Lime	3000
Shale	3064
Shale and Lime	3350
Lime	3848
Lime and shale	3980
Lime	4048
Lime and shale	4165
Lime	4343
Blue siltstone	4357
Shale	4583
Lime	4588 T. D.

Top Lansing 3872
T. D. 4362

PLUGGING	
FILE	27 30 15W
BOOK	PAUL 112 LINE 4

