


STATE OF KANSAS  
STATE CORPORATION COMMISSION

WELL PLUGGING RECORD

15-155-03217-0000

Give All Information Completely  
Make Required Affidavit  
Mail or Deliver Report to  
Conservation Division  
State Corporation Comm.  
245 North Water  
Wichita, KS 67202

Reno County. Sec. 8 Twp. 23 Rge. 9 E/W  
Location as "NE/CNW $\frac{1}{4}$ SW $\frac{1}{4}$ " or footage from lines \_\_\_\_\_  
C NW NE  
Lease Owner Mull Drilling Company  
Lease Name Lavielle #1 Well No. \_\_\_\_\_  
Office Address Wichita, Kansas 67202  
Character of Well (Completed as Oil, Gas or Dry Hole) \_\_\_\_\_

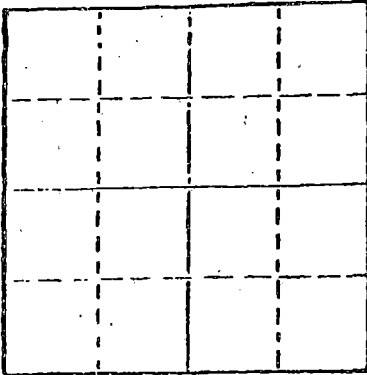

Locate well correctly on above  
Section Plat

Date Well completed \_\_\_\_\_ 19\_\_\_\_  
Application for plugging filed \_\_\_\_\_ 19\_\_\_\_  
Application for plugging approved \_\_\_\_\_ 19\_\_\_\_  
Plugging commenced 9/26/79 \_\_\_\_\_ 19\_\_\_\_  
Plugging completed 10/1/79 \_\_\_\_\_ 19\_\_\_\_  
Reason for abandonment of well or producing formation  
depleted  
If a producing well is abandoned, date of last production \_\_\_\_\_ 19\_\_\_\_

Was permission obtained from the Conservation Division or  
its agents before plugging was commenced? yes \_\_\_\_\_

Name of Conservation Agent who supervised plugging of this well Toman  
Producing formation \_\_\_\_\_ Depth to top \_\_\_\_\_ Bottom \_\_\_\_\_ Total Depth of Well 3885  
Show depth and thickness of all water, oil and gas formations.

OIL, GAS OR WATER RECORDS

CASING RECORD

FORMATION	CONTENT	FROM	TO	SIZE	PUT IN	PULLED OUT
				8-5/8	248	none
				5 $\frac{1}{2}$ "	3645	3134

Describe in detail the manner in which the well was plugged, indicating where the mud fluid  
was placed and the method or methods used in introducing it into the hold. If cement or other  
plugs were used, state the character of same and depth placed, from \_\_\_\_\_ feet to  
\_\_\_\_\_ feet for each plug set.

Sanded to 3500' and ran 5 sacks cement. Shot pipe at 3305', 3210', 3115', pulled 100 joints.  
Squeezed hole with 5 sacks hulls, 25 sacks gel, released plug and displaced with 100 sacks  
50-50 pozmix, 2% gel.

PLUGGING COMPLETE.

10-12-79

RECEIVED  
STATE CORPORATION COMMISSION

(If additional description is necessary, use BACK of this sheet)

Name of Plugging Contractor KELS0 CASING PULLING  
CHASE, KANSAS

OCT 12 1979

STATE OF KANSAS COUNTY OF RICE, ss.  
R. DARRELL KELSO (employee of owner) or (owner or operator)  
of the above-described well, being first duly sworn on oath, says: That I have knowledge of  
the facts, statements, and matters herein contained and the log of the above-described well  
as filed and that the same are true and correct. So help me God.

(Signature)

R. Darrell Kelso  
CHASE, KANSAS

(Address)

SUBSCRIBED AND SWORN TO before me this 10th day of October, 1979

Margaret Melcher  
Notary Public.

commission expires



