


Give All Information Completely
Make Required Affidavit
Mail or Deliver Report to:
Conservation Division
State Corporation Commission
212 North Market, Insurance Bldg.
Wichita, Kansas

WELL PLUGGING RECORD

Reno County, Sec. 6 Twp. 23 Rge. 9 (E) (W)

Location as "NE/CNW/SW" or footage from lines NW NE NW
Lease Owner Cities Service Petroleum Co.
Lease Name Valdois Well No. 2
Office Address Box 144, Great Bend, Kansas
Character of Well (completed as Oil, Gas or Dry Hole) Oil
Date well completed 2-27-61 19
Application for plugging filed 1-27-61 19
Application for plugging approved 1-27-61 19
Plugging commenced 1-27-61 19
Plugging completed 2-27-61 19
Reason for abandonment of well or producing formation _____

NORTH

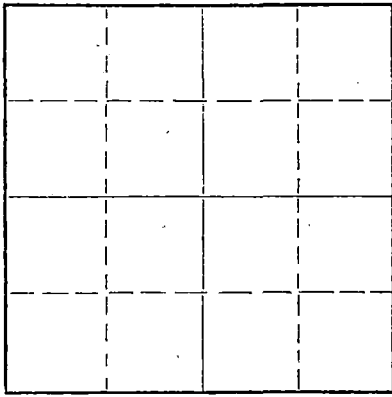

Locate well correctly on above Section Plat

If a producing well is abandoned, date of last production _____ 19____
Was permission obtained from the Conservation Division or its agents before plugging was commenced? _____

Name of Conservation Agent who supervised plugging of this well Fred Hampell
Producing formation _____ Depth to top _____ Bottom _____ Total Depth of Well 3737 Feet
Show depth and thickness of all water, oil and gas formations.

OIL, GAS OR WATER RECORDS

CASING RECORD

FORMATION	CONTENT	FROM	TO	SIZE	PUT IN	PULLED OUT

Describe in detail the manner in which the well was plugged, indicating where the mud fluid was placed and the method or methods used in introducing it into the hole. If cement or other plugs were used, state the character of same and depth placed, from _____ feet to _____ feet for each plug set.

Sand to 3690' with 5 sacks cement pulled casing
Mudded hole to 250' set 10' rock bridge with 20 sacks cement
Mud to 35' set rock bridge with 10 sacks cement to base of cellar

RECEIVED
STATE CORPORATION COMMISSION

MAR 13 1961

CONSERVATION DIVISION
Wichita, Kansas

(If additional description is necessary, use BACK of this sheet)
Name of Plugging Contractor Central Pipe Pulling
Address _____

STATE OF Kansas, COUNTY OF Barton, ss.
Central Pipe Pulling (employee of owner) or (owner or operator) of the above-described well, being first duly sworn on oath, says: That I have knowledge of the facts, statements, and matters herein contained and the log of the above-described well as filed and that the same are true and correct. So help me God.

(Signature) Richard B. Schuch

(Address)

SUBSCRIBED AND SWORN TO before me this 13 day of March, 1961

My commission expires 24 October 1964
Sidney D. Miller
Notary Public.




15455-02324-0000

WILLIAMS LEASING COMPANY KANSAS GEOLOGICAL SOCIETY
412 Union National Bldg. Wichita, Kansas

Company CITIES SERVICE OIL COMPANY
Farm - V. Idois No. 2

6 23 9W
SEC. 6 T. 23 R. 9W
NW NE NW
330' S & 990' W of N/4 corner

County. Reno
KANSAS

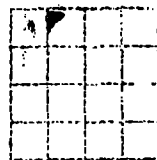

Total Depth. 3737'
Comm. 10-20-47 Comp. 11-8-47
Shot or Treated. Acid. w/500 gals. 11-10-47
Contractor R. W. Rine Drilling Company
Issued. 2-21-48

CASINGS
8 5/8" 353' cem. 25 sx.
5 1/2" 3701' cem. 135 sx.

Elev. tion. _____
Physical Potential:
Production. 80 Bbls. oil
1st vtr. - 24 hrs.

Figure 1 - Bottom of Formations.

soil	10
sand & shale	75
red bed	350
anhydrite	370
shale & salt	1215
salt	1370
shale	1430
lime	1470
shale	1700
lime	1965
shale & lime	2220
sand & shale	2255
shale & shells	2640
shale & lime	2785

lime	3145
lime & shale	3310
lime	3615
chert	3620
lime & chert	3625
shale	3660
shale & lime	3714
3714 Rot. TP - 3707 ELM	
lime	3737
Total Depth.	

TOPS:	
Corr. Top Lansing	3230
Corr. Top Mississippi	3562
Corr. Top Kinderhook	3596
Corr. Top Miscner	3701
Corr. Top Viola	3704
Penetration	33
Total Depth.	3737

2 gallons oil per hour at 3737.