


STATE OF KANSAS
STATE CORPORATION COMMISSION

WELL PLUGGING RECORD

15-155-20639-0000

Give All Information Completely
Make Required Affidavit
Mail or Deliver Report to
Conservation Division
State Corporation Comm.
245 North Water
Wichita, KS 67202

Reno County, Sec. 5 Twp. 23S Rge. 19W E/W
Location as "NE/CNW 1/4 SW 1/4" or footage from lines
E/2 NW SW
Lease Owner Energy Exploration, Inc.
Lease Name Taylor Well No. 1
Office Address 120 S. Market-Suite 606, Wichita, KS
Character of Well (Completed as Oil, Gas or Dry Hole) 67202
Dry Hole
Date Well completed March 3, 1980
Application for plugging filed Verbal Application 19
Application for plugging approved Verbal Approval 19
Plugging commenced 2-11-80 March 3, 1980
Plugging completed 2-22-80 March 3, 1980
Reason for abandonment of well or producing formation

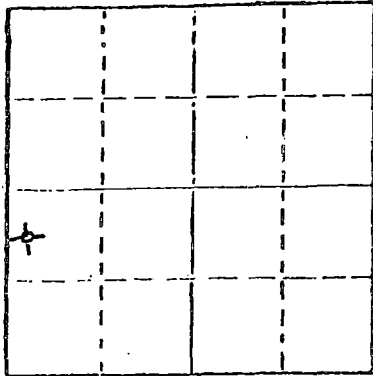

Locate well correctly on above
Section Plat

If a producing well is abandoned, date of last production 19

Was permission obtained from the Conservation Division or
its agents before plugging was commenced? Yes

Name of Conservation Agent who supervised plugging of this well Gilbert Toman
Producing formation Depth to top Bottom Total Depth of Well 3,925'
Show depth and thickness of all water, oil and gas formations.

OIL, GAS OR WATER RECORDS

CASING RECORD

FORMATION	CONTENT	FROM	TO	SIZE	PUT IN	PULLED OUT
				8-5/8"	242'	None

Describe in detail the manner in which the well was plugged, indicating where the mud fluid was placed and the method or methods used in introducing it into the hold. If cement or other plugs were used, state the character of same and depth placed, from feet to feet for each plug set.

Filled hole with heavy rotary mud from 3,925 ft. (rotary total depth) to 230 ft. Set plug at 230 ft. and cemented with 35 sacks cement. Filled hole with heavy rotary mud from 230 ft. to 40 ft. Set solid plug at 40 ft. and cemented to cellar with 10 sacks cement, 5 sacks cement in rat hole.

Plugging operations accomplished utilizing Allied Oil Well cementing pump truck through 4 1/2 inch drill pipe. 3-7-80

RECEIVED
STATE CORPORATION COMMISSION

(If additional description is necessary, use BACK of this sheet)
Name of Plugging Contractor Allied Cementing Co., Inc.
Box 31, Russell, Kansas 67665 CONSERVATION DIVISION
Wichita, Kansas

STATE OF Kansas COUNTY OF Sedgwick ss.
Dean Britting, Agent (Employee of owner) or (Owner) or (Operator)

of the above-described well, being first duly sworn on oath, says: That I have knowledge of the facts, statements, and matters herein contained and the log of the above-described well as filed and that the same are true and correct. So help me God.

(Signature) Dean Britting
200 N. Main, Wichita, Kansas 67202
(Address)

SUBSCRIBED AND SWORN TO before me this 3rd day of March, 1980

My commission expires July 25, 1980
Elsie Willison - Notary Public.



KANSAS DRILLERS LOG

COMPANY Energy Exploration, Inc.

SEC. 5 T. 23S R. 9W

FARM Taylor NO. 1

LOC. NW SW

COUNTY Reno

ROTARY TOTAL DEPTH 3,925'

COMM. February 11, 1980 COMP. February 22, 1980

CONTRACTOR H-30, INC. (Rig #7)

ISSUED March 3, 1980

CASING

10 3/4"

8 5/8" Set at 242' cemented w/225 sxs cement

ELEVATION 1,748' K.B.

5 1/2"

4 1/2"

FIGURES INDICATE BOTTOM OF FORMATIONS

Red Bed, Shale and Shells	408'
Shale	1,370'
Shale and Lime	2,559'
Lime and Shale	3,925'
Rotary Total Depth	3,925'

I hereby certify the above and foregoing to be a true and correct log of the above described well as shown by the drilling reports.

H-30, INC.

Dean Britting
Dean Britting

State of Kansas)
) SS:
County of Sedgwick)

Subscribed and Sworn to before me a Notary Public in and for said county and state this 3rd day of March, 1980.

Elsie Willison
Elsie Willison - Notary Public

My Commission Expires:
July 25, 1982

RECEIVED
STATE CORPORATION COMMISSION
MAR - 7 1980
CONSERVATION DIVISION
Wichita, Kansas