


STATE OF KANSAS
STATE CORPORATION COMMISSION

Give All Information Completely
Make Required Affidavit
Mail or Deliver Report to:
Conservation Division
State Corporation Commission
212 North Market, Insurance Bldg.
Wichita, Kansas

15.063.00-125.00.00
WELL PLUGGING RECORD

NORTH

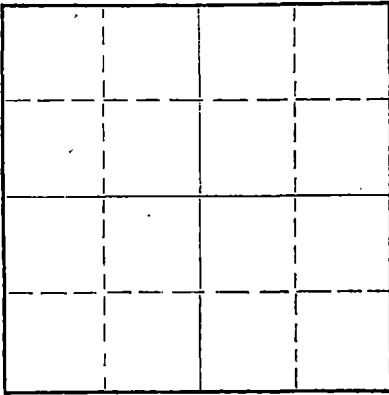

Locate well correctly on above
Section Plat

Gove County, Sec. 24 Twp. 11s Rge. 16w (E) (W)

Location as "NE/CNW/SW" or footage from lines C NE SE
Lease Owner John O. Farmer, Inc.
Lease Name Wolf Well No. # 1
Office Address P.O. Box 352, Russell, Kansas
Character of Well (completed as Oil, Gas or Dry Hole) Dry
Date well completed 9/21 1964
Application for plugging filed 9/21 1964
Application for plugging approved 9/21 1964
Plugging commenced 9/21 1964
Plugging completed 6:30 P.M. 9/21 1964
Reason for abandonment of well or producing formation Dry

If a producing well is abandoned, date of last production _____ 19____
Was permission obtained from the Conservation Division or its agents before plugging was commenced? Yes

Name of Conservation Agent who supervised plugging of this well Bill Nichols, Morland, Kansas
Producing formation _____ Depth to top _____ Bottom _____ Total Depth of Well 4080 Feet
Show depth and thickness of all water, oil and gas formations.

OIL, GAS OR WATER RECORDS

CASING RECORD

FORMATION	CONTENT	FROM	TO	SIZE	PUT IN	PULLED OUT

Describe in detail the manner in which the well was plugged, indicating where the mud fluid was placed and the method or methods used in introducing it into the hole. If cement or other plugs were used, state the character of same and depth placed, from _____ feet to _____ feet for each plug set.

Plug # 1 540' 20 sx. cement
Plug # 2 150' 20 sx. cement
Plug # 3 40' 10 sx. cement

Completed: 6:30 P.M. 9/21/64

9-25-64
RECEIVED
STATE CORPORATION COMMISSION
SEP 25 1964
CONSERVATION DIVISION
Wichita, Kansas

(If additional description is necessary, use BACK of this sheet)

Name of Plugging Contractor John O. Farmer, Inc.
Address P.O. Box 352, Russell, Kansas

STATE OF KANSAS, COUNTY OF RUSSELL, ss.
John O. Farmer, President (employee of owner) or (owner or operator) of the above-described well, being first duly sworn on oath, says: That I have knowledge of the facts, statements, and matters herein contained and the log of the above-described well as filed and that the same are true and correct. So help me God.

(Signature) John O. Farmer
P.O. Box 352, Russell, Kansas
(Address)

SUBSCRIBED AND SWORN TO before me this 23rd. day of September, 1964

My commission expires February 15, 1967

Helen Carlson
Helen Carlson Notary Public.

