


Give All Information Completely  
Make Required Affidavit  
Mail or Deliver Report to:  
Conservation Division  
State Corporation Commission  
211 No. Broadway  
Wichita, Kansas

WELL PLUGGING RECORD

NORTH

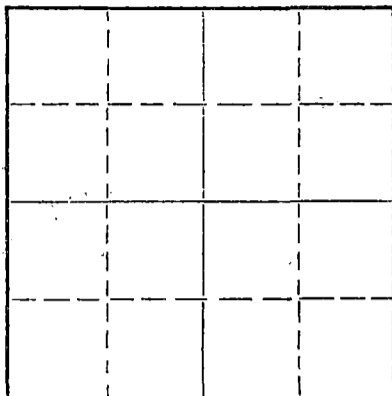

Locate well correctly on above  
Section Plat

Gove County, Sec. 3 Twp. 12 Rge. (E) 30 (W)  
Location as "NE/CNW%SW%" or footage from lines C NW NW  
Lease Owner Pickrell Drilling Company  
Lease Name Jenson "L" Well No. 1  
Office Address 705 4th Natl Bank Bldg, Wichita, Kansas  
Character of Well (completed as Oil, Gas or Dry Hole) Dry Hole  
Date well completed September 14, 19 63  
Application for plugging filed September 14, 19 63  
Application for plugging approved September 14, 19 63  
Plugging commenced September 14, 19 63  
Plugging completed September 14, 19 63  
Reason for abandonment of well or producing formation Dry Hole

If a producing well is abandoned, date of last production 19  
Was permission obtained from the Conservation Division or its agents before plugging was commenced? Yes

Name of Conservation Agent who supervised plugging of this well Gilbert P. Leiker  
Producing formation Depth to top Bottom Total Depth of Well Feet  
Show depth and thickness of all water, oil and gas formations.

OIL, GAS OR WATER RECORDS

CASING RECORD

FORMATION	CONTENT	FROM	TO	SIZE	PUT IN	PULLED OUT
				8 5/8"	225'	None

Describe in detail the manner in which the well was plugged, indicating where the mud fluid was placed and the method or methods used in introducing it into the hole. If cement or other plugs were used, state the character of same and depth placed, from feet to feet for each plug set.

Heavy mud to 210'. Set plug. Cemented with  
20 sacks cement. Heavy mud to 40'. Set plug.  
Cemented with 10 sacks cement to bottom of  
cellar. Plugged rat hole with 2 sacks cement.

RECEIVED  
STATE CORPORATION COMMISSION

SEP 19 1963

CONSERVATION DIVISION  
Wichita, Kansas

(If additional description is necessary, use BACK of this sheet)  
PICKRELL DRILLING COMPANY

Name of Plugging Contractor PICKRELL DRILLING COMPANY  
Address 705 4th Natl Bank Bldg, Wichita, Kansas

STATE OF KANSAS, COUNTY OF SEDGWICK, ss.  
C. W. SEBITS (Notary Public) of the above-described well, being first duly sworn on oath, says: That I have knowledge of the facts, statements, and matters herein contained and the log of the above-described well as filed and that the same are true and correct. So help me God.

(Signature) C. W. Sebts  
705 4th National Bank Bldg, Wichita, Kansas  
(Address)

SUBSCRIBED AND SWORN TO before me this 18th day of September, 19 63

Maxine Blackman  
Notary Public.

My commission expires June 21, 1966

ROTARY DRILLING LOG

COMPANY: PICKRELL DRILLING COMPANY  
 705 4th National Bank Bldg  
 Wichita 2, Kansas  
 LOCATION: Jenson "L" No. 1, C NW NW 3-12-30W  
 Gove County, Kansas

Rotary Drilling Commenced 9-1-63  
 Rotary Drilling Completed 9-14-63

CONTRACTOR: **PICKRELL DRILLING COMPANY**  
 Wichita, Kansas

CASING RECORD: (6 jts) 8 5/8" Surface Casing set at 225', cemented with 160 sacks cement. Circulated. Completed 4:15 P.M. September 1, 1963. No oil string run. D & A.

LOG

(Figures indicate bottom of formation — measurements from top of rotary bushing.)

150	Sandy Clay	<u>C. F. S.</u>
225	Blue Shale	4015
1085	Shale	4056
1275	Shale & Shells	4064
1435	Sand	4100
1600	Shale & Shells	4145
1665	Sand	4160
1695	Shale	4185
1780	Sand	4200
1905	Shale	4232
1940	Blaine	4380
2340	Shale & Shells, Red Bed	4442
2360	Anhydrite	4480
2475	Shale & Shells	4490
2760	Lime & Shale	4500
2885	Sandy, Lime & Shale	4510
2915	Lime & Shale	4545
3020	Lime	
3210	Lime & Shale	
3465	Lime	<u>Slope Test</u>
3875	Shale & Lime	2500
4232	Lime	3000
4340	Lime & Shale	3500
4380	Lime	4000
4435	Lime & Shale	
4499	Lime	<u>S. L. M.</u>
4548	Mississippian - TD	3435
		3988
		4327

**RECEIVED**  
 STATE CORPORATION COMMISSION  
 SEP 19 1963  
 CONSERVATION DIVISION  
 Wichita, Kansas

The undersigned, CARL W. SEBITS, Attorney-in-Fact for PICKRELL DRILLING COMPANY, hereby certifies in behalf of said Company, that the above is a true and correct log of the formation encountered in drilling the above well as reflected by the Daily Drilling Reports.

**PICKRELL DRILLING COMPANY**

By *[Signature]*  
 C. W. Sebitts Attorney-in-Fact

STATE OF KANSAS }  
 COUNTY OF SEDGWICK } ss.:

On this 18th day of September, 19 63, before me the undersigned, a Notary Public, in and for the County and State aforesaid, personally appeared C. W. Sebitts, to me known to be the identical person who subscribed the name of PICKRELL DRILLING COMPANY to the foregoing instrument as its Attorney-in-Fact and acknowledged to me that he executed the same as his free and voluntary act and deed, and as the free and voluntary act and deed of such company, for the uses and purposes therein set forth.

Given under my hand and seal of office the day and year last above written.

My commission expires: June 21, 1966

*[Signature]*  
 Maxine Blackman Notary Public