

Give All Information Completely
Make Required Affidavit
Mail or Deliver Report to:
Conservation Division
State Corporation Commission
211 No. Broadway
Wichita, Kansas

WELL PLUGGING RECORD

15.063.00095.00.00

Gove County, Sec. 7 Twp. 14 Rge. 29 (E) (W)

Location as "NE/CNW&SW&" or footage from lines C SE SE

Lease Owner Terrel Drilling & Producing

Lease Name Wakefield Well No. 1

Office Address Box 606, Russell, Kansas

Character of Well (completed as Oil, Gas or Dry Hole) Dry Hole

Date well completed 12-9-1963

Application for plugging filed 12-9-1963

Application for plugging approved 12-9-1963


Plugging commenced 12-9-1963

Plugging completed 12-9-1963

Reason for abandonment of well or producing formation

If a producing well is abandoned, date of last production 19

Was permission obtained from the Conservation Division or its agents before plugging was commenced? Yes

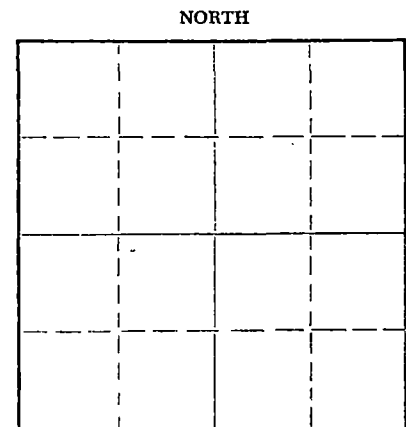

Locate well correctly on above Section Plat

Name of Conservation Agent who supervised plugging of this well Bill Nichols

Producing formation Depth to top Bottom Total Depth of Well 4625 Feet

Show depth and thickness of all water, oil and gas formations.

OIL, GAS OR WATER RECORDS

CASING RECORD

FORMATION	CONTENT	FROM	TO	SIZE	PUT IN	PULLED OUT
		0	220'	8 5/8"	220'	-0-

Describe in detail the manner in which the well was plugged, indicating where the mud fluid was placed and the method or methods used in introducing it into the hole. If cement or other plugs were used, state the character of same and depth placed, from feet to feet for each plug set.

Plugged at 600' with 20 sks cement through the frill pipe. Plug at 190' with 20 sks. cement, 1/4 sk. hulls. Plug at 40' with 10 sks. cement, 1/2 sk. hulls.

12-20-63

RECEIVED
STATE CORPORATION COMMISSION

DEC 20 1963
12-20-63
CONSERVATION DIVISION
Wichita, Kansas

(If additional description is necessary, use BACK of this sheet)

Name of Plugging Contractor Terrel Drilling and Producing
Address Box 606, Russell, Kansas

STATE OF Kansas, COUNTY OF Russell, ss. Joe K. Branum (employee of owner) or (owner or operator) of the above-described

well, being first duly sworn on oath, says: That I have knowledge of the facts, statements, and matters herein contained and the log of the above-described well as filed and that the same are true and correct. So help me God.

(Signature) Joe K. Branum
Box 606, Russell, Kansas (Address)

SUBSCRIBED AND SWORN TO before me this 17th day of December, 19 63

L. Lee Simpson
Notary Public.

My commission expires 12-12-66

RECEIVED
STATE CORPORATION COMMISSION

DEC 20 1963

CONSERVATION DIVISION
Wichita, Kansas

W E L L L O G

OPERATOR: Terrel Drilling & Producing
Box 606
Russell, Kansas

CONTRACTOR: Company Tools

LEASE: Wakefield #1

COMMENCED: November 22, 1963

LOCATION: C SE SE 7-14-29W
Gove County, Kansas

COMPLETED: December 9, 1963

DEPTHS & FORMATIONS


Surface Clay	205	Shale & Lime Chalk	3295
Shale & Shells	315	Lime & Shale	3550
Shale & Lime	846	Lime, Shale & Chalk	3647
Shale & Shells	1645	Shale & Chalky Lime	3730
Dakota Sand, Shale & Pyrite	1665	Lime	3782
Shale & Anhydrite	1808	Lime & Shale	3920
Shale & Gyp	2160	Lime	3999
Anhydrite	2195	Lime & Shale	4056
Shale & Shells	2275	Lime	4125
Lime & Shale	2462	Lime & Shale	4255
Shale, Red Bed w/Lime Streaks	2595	Lime	4281
Shale & Lime	2773	Lime & Shale	4330
Lime	2840	Lime	4410
Lime & Shale	3070	Lime & Shale	4540
Shale & Lime	3240	Mississippi Lime & Shale	4555
		Cherty Lime & Shale (R.T.D.)	4625

STATE OF KANSAS)
COUNTY OF RUSSELL) ss...

Joe K. Branum, owner of Terrel Drilling and Producing, being first duly sworn on oath says: "That I have knowledge of the facts, statements and matters herein contained and the log of the above described well as filed and that the same are true and correct."


Joe K. Branum - TERREL DRILLING & PRODUCING

Subscribed and sworn before me this 17th day of December, 1963.

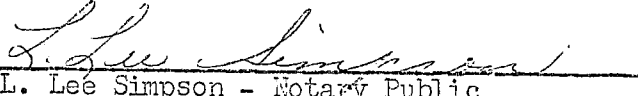
L. Lee Simpson - Notary Public

My Commission Expires December 12, 1966.