

STATE OF KANSAS
STATE CORPORATION COMMISSION

15.063.20455-00.00
WELL PLUGGING RECORD

Give All Information Completely
Make Required Affidavit
Mail or Deliver Report to
Conservation Division
State Corporation Comm.
245 North Water
Wichita, KS 67202

Gove County, Sec. 36 Twp. 14 Rge. 28 E/W
Location as "NE/CNW/SW" or footage from lines
~~SE-SE-NW~~ NE SE NW

Lease Owner Kansas Oil Corp.
Lease Name Leighton Well No. 1
Office Address 555 N. Woodlawn Wichita, Ks
Character of Well (Completed as Oil, Gas or Dry Hole)

✓ oil Dry Hole
Date Well completed 4-30 1980
Application for plugging filed 6-18 1980
Application for plugging approved 6-20 1980
Plugging commenced 8-5 1980
Plugging completed 8-7 1980


Reason for abandonment of well or producing formation
Non Commercial Value

If a producing well is abandoned, date of last production
✓ Non Applicable 19

Was permission obtained from the Conservation Division or
its agents before plugging was commenced? yes

Name of Conservation Agent who supervised plugging of this well Mr. Balthazar

✓ Producing formation Lansing NONE Depth to top 3908 Bottom 3938 Total Depth of Well 4010
Show depth and thickness of all water, oil and gas formations.

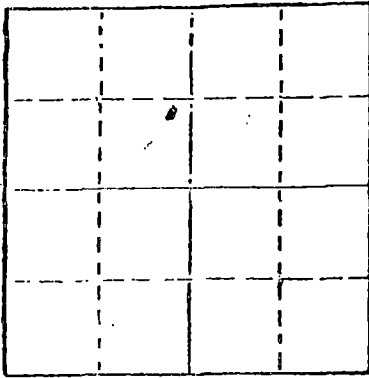

Locate well correctly on above
Section Plat

OIL, GAS OR WATER RECORDS

CASING RECORD

FORMATION	CONTENT	FROM	TO	SIZE	PUT IN	PULLED OUT
Surface				8 5/8	254'	
Production				4 1/2	3999'	2536'

Describe in detail the manner in which the well was plugged, indicating where the mud fluid was placed and the method or methods used in introducing it into the hold. If cement or other plugs were used, state the character of same and depth placed, from _____ feet to _____ feet for each plug set.

Plugged Bottom with 1 Sk. Hulls & 10 Sk. cement to 3450'
Plugged top w/3 Sk Hulls - 70 cement 5 Sk Gel & 60 cement
Pressured to 300 lbs.

Allied pump trucks

RECEIVED
STATE CORPORATION COMMISSION

SEP 23 1980

9-23-80

CONSERVATION DIVISION
WICHITA, KANSAS

(If additional description is necessary, use back of this sheet)

Name of Plugging Contractor Midwest Casing Pulling, Box F, Sublette, Ks. 67877 Permit # 766

STATE OF Kansas COUNTY OF Haskell, ss.
I, Edgar J. Eves (employee of owner) or (owner or operator)
of the above-described well, being first duly sworn on oath, says: That I have knowledge of the facts, statements, and matters herein contained and the log of the above-described well as filed and that the same are true and correct. So help me God.

(Signature)

Edgar J. Eves
Box F Sublette Ks. 67877
(Address)


SUBSCRIBED AND SWORN TO before me this 17th day of August, 1980

Sondra L Eves
Notary Public.

My commission expires 12-6-80



SPARTAN DRILLING CORPORATION

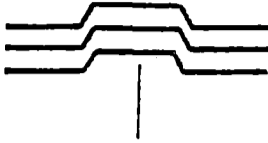

RECEIVED
STATE CORPORATION COMMISSION
JUN 23 1980
CONSERVATION DIVISION
Wichita, Kansas

May 7, 1980

DRILLERS LOG

✓ 5.063.20455.00.00

Re: Leighton #1
NE-SE-NW
Sec. 36 T14S-R28W
Grove County, Kansas

OPERATOR: Kansas Oil Corporation
CONTRACTOR: Spartan Drilling Corporation
COMMENCED: 4-22-80
COMPLETED: 4-30-80

Surface Pipe 253 ft. 8 5/8" w/180 sx common 2% gel 3% cc

0	260	Shale
260	1366	Sand & Shale
1366	1927	Shale
1927	1963	Anhydrite
1963	2327	Shale with Lime Streaks
2327	3031	Lime & Shale
3031	3808	Shale & Lime
3808	4012	Lime
4012		RTD

We certify that the above and foregoing is a true and correct copy of the log on the Leighton #1 located in Grove County, Kansas.

Spartan Drilling Corporation

Floyd C. Wilson
President

Subscribed and sworn to before me this 7th. day of May, 1980.

Carol E. Wilson Notary Public