

15.063.30007.00.00


WELL PLUGGING RECORD

Give All Information Completely
Make Required Affidavit
Mail or Deliver Report to:
Conservation Division
State Corporation Commission
211 No. Broadway
Wichita, Kansas

Gove County, Sec. 34 Twp. 14S Rge. 26W (E) (W)

Location as "NE/CNW/SW" or footage from lines C SW SW
Lease Owner Morrison Producing Co. & McClure Oil Co.
Lease Name Albin Well No. 1
Office Address 722 Union Center, Wichita, Kansas
Character of Well (completed as Oil, Gas or Dry Hole) Dry Hole
Date well completed 4-11-65 1965
Application for plugging filed 4-11-65 1965
Application for plugging approved 4-11-65 1965
Plugging commenced 4-11-65 1965
Plugging completed 4-11-65 1965
Reason for abandonment of well or producing formation Dry Hole

NORTH

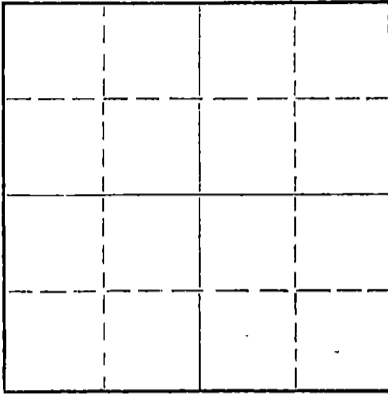

Locate well correctly on above
Section Plat

If a producing well is abandoned, date of last production _____ 19____

Was permission obtained from the Conservation Division or its agents before plugging was commenced? yes

Name of Conservation Agent who supervised plugging of this well W. L. Nichols, Moreland, Kansas

Producing formation _____ Depth to top _____ Bottom _____ Total Depth of Well 4330 Feet

Show depth and thickness of all water, oil and gas formations.

OIL, GAS OR WATER RECORDS

CASING RECORD

FORMATION	CONTENT	FROM	TO	SIZE	PUT IN	PULLED OUT
				8 5/8"	109'	none

Describe in detail the manner in which the well was plugged, indicating where the mud fluid was placed and the method or methods used in introducing it into the hole. If cement or other plugs were used, state the character of same and depth placed, from _____ feet to _____ feet for each plug set.

Mud to 540' Spotted 15 sks. cement through drill pipe
Mud to 120' Plug 20 sks. cmnt.
Mud to 40' Plug 1/2 sk. hulls 10 sks. cement

4-14-65

RECEIVED
STATE CORPORATION COMMISSION
APR 14 1965
CONSERVATION DIVISION
Wichita, Kansas

(If additional description is necessary, use BACK of this sheet)

Name of Plugging Contractor Leben Drilling, Inc.
Address Box 486, Great Bend, Kansas

STATE OF KANSAS, COUNTY OF BARTON, ss.
Leslie Kite (employee of owner) or (operator) of the above-described well, being first duly sworn on oath, says: That I have knowledge of the facts, statements, and matters herein contained and the log of the above-described well as filed and that the same are true and correct. So help me God.

(Signature) Leslie Kite

P. O. Box 486, Great Bend, Kansas
(Address)

SUBSCRIBED AND SWORN TO before me this 13th day of April, 1965

Wanda [Signature]
Notary Public.

My commission expires April 1, 1967

INVOICED

DATE 8/6/65

INV. NO. 1584-W

DRILLER'S LOG

COMPANY: Morrison Producing Company & McClure Oil Company
 CONTRACTOR: LEBEN DRILLING, INC.
 FARM: ALBIN #1
 LOCATION: C SW SW Sec. 34-14S-26W GOVE COUNTY, KANSAS
 COMMENCED: 4-1-65
 COMPLETED: 4-11-65

0	20	Sand
20	160	Post Rock
160	980	Shale
980	1480	Shale & Shells with Lime Streaks
1480	1845	Shale & Redbed
1845	1895	Anhydrite & Shale
1895	2770	Shale & Lime
2770	3265	Lime & Shale
3265	3410	Lime
3410	3685	Lime & Shale
3685	3835	Lime
3835	3936	Lime & Shale
3936	4330	Lime
	<u>4330</u>	<u>RTD - D & A</u>

RECEIVED
 STATE CORPORATION COMMISSION
 APR 14 1965
 CONSERVATION DIVISION
 Wichita, Kansas

Set 8 5/8" used surface casing @ 109' cemented with 100 sacks
 60-40 Posmix Sunset 2% Gel

I, Leslie Kite, do hereby certify that the above and foregoing is a true and correct copy of the log of the Albin #1 well, located C SW SW of Section 34, Township 14 South, Range 26 West, Gove County, Kansas, as reflected by the records of Leben Drilling, Inc.

Leslie Kite

Leslie Kite

STATE OF KANSAS)
) SS
 COUNTY OF BARTON)

Subscribed and sworn to before me, a Notary Public, in and for Barton County, Kansas, this 13th day of April, 1965.

Ulanda Nichols

Ulanda Nichols

My Commission Expires
 April 1, 1967