

WELL PLUGGING RECORD

OR

FORMATION PLUGGING RECORD

Strike out upper line when reporting plugging of formations.

Give All Information Completely  
Make Required Affidavit  
Mail or Deliver Report to:  
Conservation Division  
State Corporation Commission,  
800 Bittling Building,  
Wichita, Kansas

15.063.00009.00.00

Gove County. Sec. 36 Twp. 13S Rge. (E) 30 (W)

Location as "NE 1/4 NW 1/4 SW 1/4" or footage from lines 1320' S - 400' E NW Cor

Lease Owner Helmerich & Payne, Inc.

Lease Name Victory Life Well No. 1

Office Address 415 Philtower - Tulsa

Character of Well (Completed as Oil, Gas or Dry Hole) Dry

Date, well completed 2-28 1940

Application for plugging filed 2-28 1940

Application for plugging approved 2-28 1940


Plugging Commenced 2-28 1940

Plugging Completed 2-28 1940

Reason for abandonment of well or producing formation Dry

If a producing well is abandoned, date of last production 193

Was permission obtained from the Conservation Division or its agents before plugging was commenced? Yes - Telephoned verbally

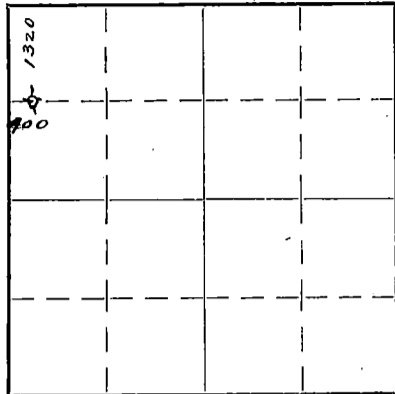

Locate well correctly on above Section Plat

Name of Conservation Agent who supervised plugging of this well

Producing formation None Depth to top Bottom Total Depth of Well 5169 Feet

Show depth and thickness of all water, oil and gas formations.

OIL, GAS OR WATER RECORDS

CASING RECORD

Formation	Content	From	To	Size	Put In	Pulled Out
Quartzite & Granite	Water	5166'	5169'	13"	110'	100 sacks

Describe in detail the manner in which the well was plugged, indicating where the mud fluid was placed and the method or methods used in introducing it into the hole. If cement or other plugs were used, state the character of same and depth placed, from feet to feet for each plug set.

Filled hole with heavy mud to bottom of 13" - set bridge & cemented at 110' with 30 sacks - bridged hole 6 feet below cellar & cemented with 10 sacks cement.

3-12-40

PLUGGING  
FILE SEC 36-13R30W  
BOOK PAGE 94 LINE 1



(If additional description is necessary use BACK of this sheet)

Correspondence regarding this well should be addressed to Helmerich & Payne, Inc.,  
Address 415 Philtower

STATE OF Oklahoma COUNTY OF Tulsa, ss.

E M Copeland (employee of owner) or (owner or operator) of the above-described well, being first duly sworn on oath, says: That I have knowledge of the facts, statements, and matters herein contained and the log of the above-described well as filed and that the same are true and correct. So help me God.

(Signature) E M Copeland

Tulsa, Okla (Address)

SUBSCRIBED AND SWORN to before me this 11th day of March, 1940

My commission expires July 22, 1943  
16-1484 11-35-5M Notary Public.


Victory Life #1  
1320' S. and 400' E. of the NW Cor. of Sec. 36-13S-30W  
Gove County, Kansas  
Cities Service Oil Company

Commenced: January 8, 1940  
 Completed: February 28, 1940

Surface chalk, Rock and shale	0 198	: Lime	3966 4029
Shale	198 513	Hard lime	4029 4064
Chalky lime and shale	513 595	Broken cherty lime	4064 4099
Black shale and shells	595 740	Lime	4099 4103
Shale	740 805	Black shale and lime	4103 4123
Lime and shale (broken)	805 940	Shale and lime	4123 4129
Shale and lime	940 965	Lime	4129 4180
Sand and shale	965 1485	Hard lime - tuf shale	4180 4225
Sand	1485 1516	Lime and shale	4225 4262
Shale	1516 1550	Lime	4262 4279
Shale and sand (Fyrite)	1550 1650	Broken lime and shale	4279 4325
Shale and red bed	1650 1736	Lime and shale	4325 4360
Anhydrite and gyp	1736 1770	Lime - little shale	4360 4407
Shale and red bed	1770 2095	Lime and shale	4407 4412
Shale and shells	2095 2225	Dolomite, chert and lime	4412 4435
Anhydrite, shale and red bed	2225 2298	Cherty lime	4435 4453
Shale and shells	2298 2395	Cherty Miss. Lime	4453 4478
Shale	2395 2496	Cherty lime	4478 4485
Broken lime	2496 2516	Bony chert and sand	4485 4520
Shale and shells - lime	2516 2550	Chalky white lime	4520 4534
Shale and shells	2550 2580	Lime (little chert)	4534 4544
Lime	2580 2615	Sand	4544 4561
Broken lime	2615 2760	Dolomite lime	4561 4590
Shale and lime	2760 2823	Dolomite cherty	4590 4638
Sandy lime	2823 2845	Dolomite	4638 4670
Sand	2845 2860	Dolomite and chert	4670 4700
Shale and broken lime	2860 2898	Cherty dolomite	4700 4722
Broken lime	2898 2908	Sharp sand, hard	4722 4723
Sandy lime	2908 2923	Hard sand, chert	4723 4819
Shale and lime shells	2923 2984	Lime	4819 4873
Shale and lime	2984 3045	Lime, cherty	4873 4937
Sand	3045 3067	Lime	4937 5062
Shale and lime	3067 3165	Sandy dolomite	5062 5097
Lime	3165 3182	Sand and dolomite	5097 5105
Lime broken	3182 3201	Sandy dolomite	5105 5122
Shale, Limey	3201 3237	Sand-Dolomite and shale	5122 5158
Sand	3237 3245	Sand and dolomite	5158 5166
Broken lime and shale	3245 3297	Quartzite and granite	5166 5169
Broken lime	3297 3357		
Shale and lime	3357 3420	TOTAL DEPTH	5169
Lime	3420 3471		
Sandy lime	3471 3483		
Lime	3483 3500		
Lime and shale	3500 3568		
Broken lime	3568 3575		
Black shale	3575 3588		
Lime	3588 3682		
Lime and shale streaks	3682 3710		
Lime	3710 3740		
Lime and shale	3740 3800		
Lime	3800 3926		
Lime and littly cherty	3926 3965		

CASING RECORD

15" Surface Casing set at 1105  
 and cemented with 100 sacks of  
 cement.

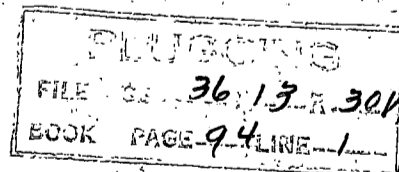

STATE OF OKLAHOMA )  
 ) ss.  
 COUNTY OF TULSA )

I hereby affirm that the above and foregoing is a true and correct copy of the log of your Victory Life Well #1, located 1320' South and 400' East of the Northwest Corner of Section 36, Township 13 South, Range 30 West, Gove County, Kansas.

HILLMERTICH & PAYNE, INC.

BY [Signature]

Asst. Secretary

Subscribed and sworn to before me, a Notary Public, this 4th. day of March, 1940.

[Signature]  
 Notary Public

My commission expires July 22, 1943.