

STATE OF KANSAS
STATE CORPORATION COMMISSION
200 Colorado Derby Building
Wichita, Kansas 67202

WELL PLUGGING RECORD
K.A.R.-82-3-117

API NUMBER 15-095-00813-0001
N/A

LEASE NAME Cox B

WELL NUMBER 2

660 Ft. from S Section Line

4620 Ft. from E Section Line

SEC. 19 TWP. 29S RGE. 6 (XXX(W))

COUNTY Kingman

Date Well Completed 4/62

Plugging Commenced 7-7-93

Plugging Completed _____

TYPE OR PRINT
NOTICE: Fill out completely
and return to Cons. Div.
office within 30 days.

LEASE OPERATOR Pickrell Drilling Co., Inc.

ADDRESS 110 N. Market, Suite 205, Wichita, KS

PHONE#(316) 262-8427 OPERATORS LICENSE NO. 5123

Character of Well good

(Oil, Gas, D&A, SWD, Input, Water Supply Well)

The plugging proposal was approved on July 6, 1993 (date)

by Moorse (KCC District Agent's Name).

Is ACO-1 filed? yes If not, is well log attached? yes

Producing Formation KC Depth to Top _____ Bottom _____ T.D. _____

Show depth and thickness of all water, oil and gas formations.

OIL, GAS OR WATER RECORDS

CASING RECORD

Formation	Content	From	To	Size	Put In	Pulled out
				8.5/8	208	None
				5 1/2	4485	2666

Describe in detail the manner in which the well was plugged, indicating where the mud fluid was placed and the method or methods used in introducing it into the hole. If cement or other plugs were used, state the character of same and depth placed, from _____ feet to _____ feet each section. Sanded to 3650 use dump bailer spotted 5sx cement at 3650, pulled 2666 of casing, ran tubing to 1100, spotted 35sx cement, pulled tubing to 200, spotted 35sx cement, pulled tubing to 258, circulated to surface, pulled tubing, filled with cement.

(If additional description is necessary, use BACK of this form.)

Name of Plugging Contractor Clarke Corporation License No. 5105

Address P.O. Box 187, Medicine Lodge, KS 67104 7-28-93

NAME OF PARTY RESPONSIBLE FOR PLUGGING FEES: Pickrell Drilling Co. Inc. STATE CORPORATION COMMISSION


STATE OF Kansas COUNTY OF Barber, ss.

Jeff Sletto (Employee of Operator) or (Operator)

above-described well, being first duly sworn on oath, says: That I have knowledge of the fact statements, and matters herein contained and the log of the above-described well as filed to the same are true and correct, so help me God.

(Signature) Jeff Sletto

(Address) Medicine Lodge, KS 67104

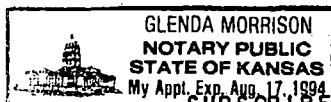

SUBSCRIBED AND SWORN TO before me this 27 day of July, 19 93

Glenda Morrison
Notary Public


My Commission Expires: Aug. 17, 1994

BAKER SERVICE TOOLS - TALLY PAD

New Completion Workover

Oil Company _____ Well No. 2 Field Basil Lease Cox "B"
Company Man _____ Date Drilled 4/62 County Kingman State KS

15095-00813-0001

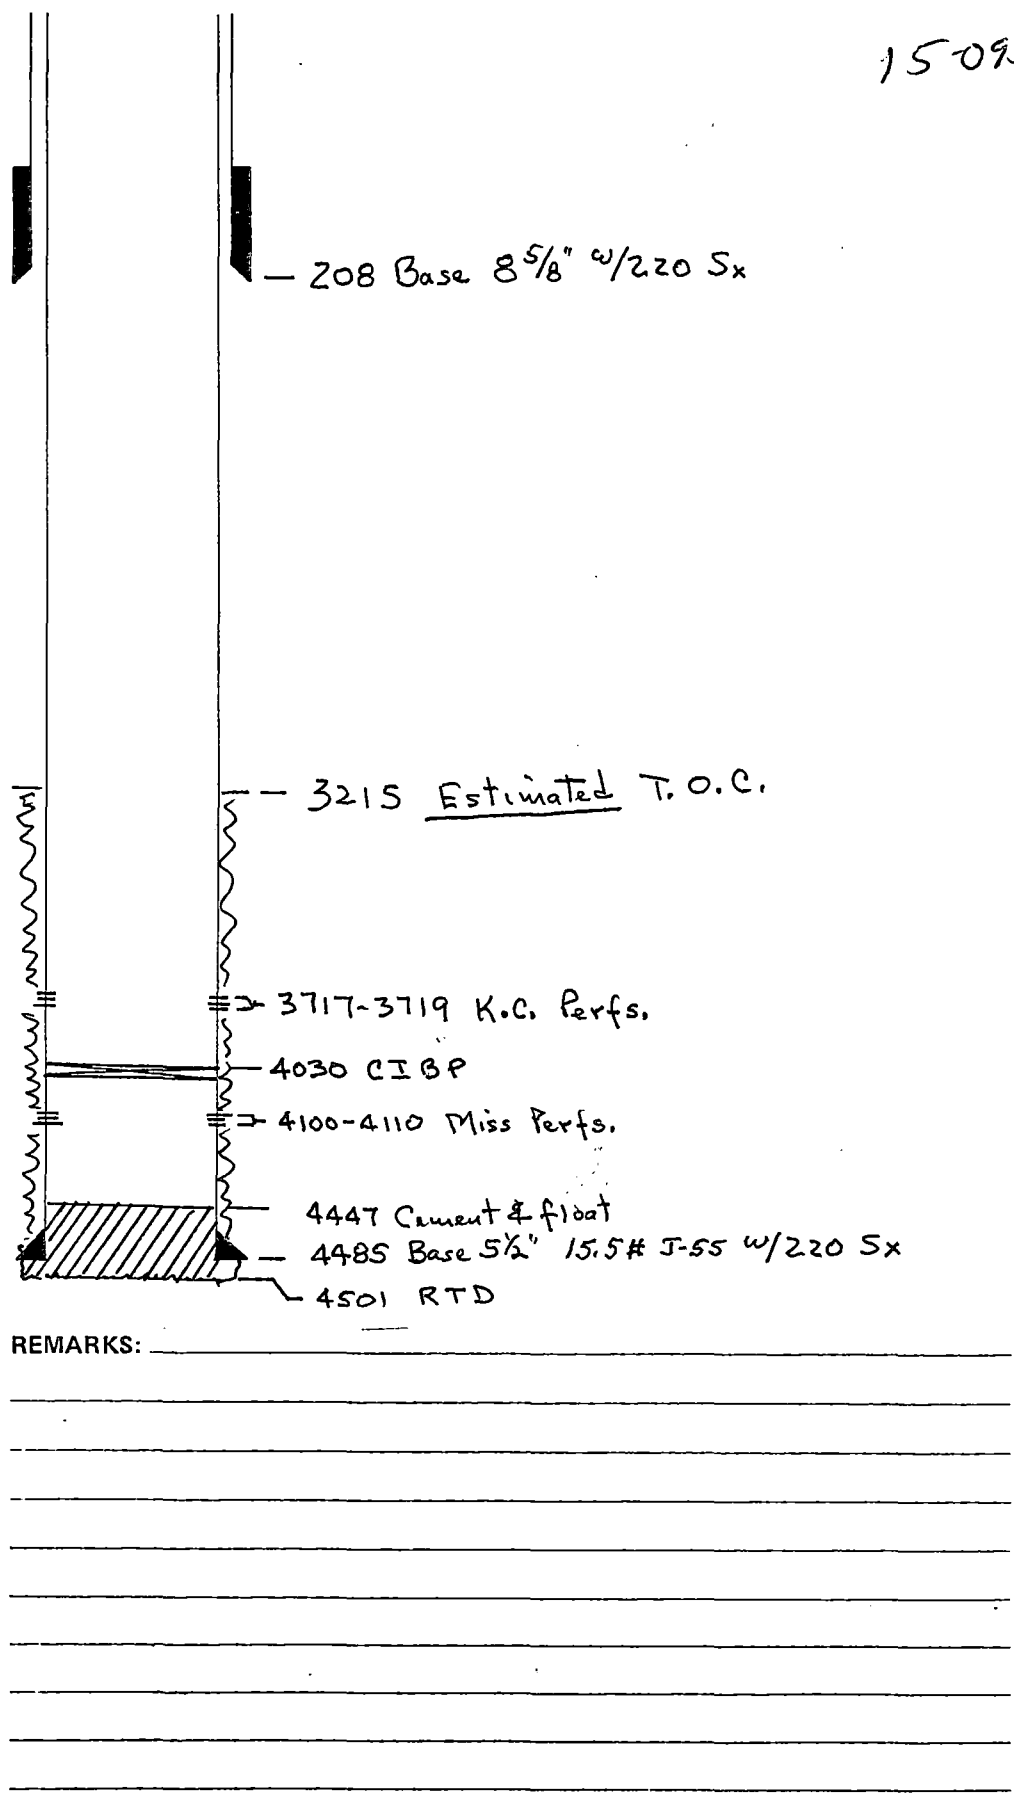

REMARKS: _____

RECEIVED
STATE CORPORATION COMMISSION
JUN 1 1993
CONSERVATION DIVISION
Wichita, Kansas