


STATE OF KANSAS
STATE CORPORATION COMMISSION

Give information Completely
Make required Affidavit
Make a correct Report to:
Conservation Division
State Corporation Commission
222 No. Market
Wichita, Kansas

WELL PLUGGING RECORD

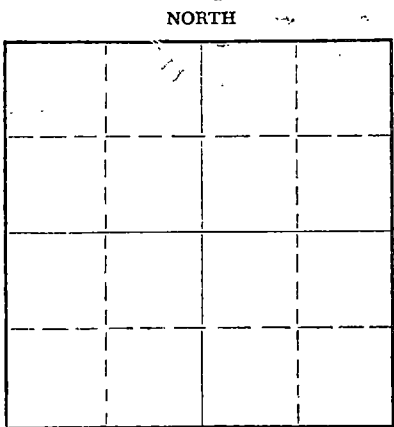

Locate well correctly on above
Section Plat

Kingman County. Sec. 19 Twp. 29 Rge. 6 (E) (W) x
Location as "NE/CN/W%SW%" or footage from lines C-SW-NE
Lease Owner Monarch Oil Co. SW
Lease Name Osborne Well No. #1
Office Address 1429 Wichita Plaza Wichita, Kansas
Character of Well (completed as Oil, Gas or Dry Hole)
Date well completed 19
Application for plugging filed 12-10-68 19
Application for plugging approved 19
Plugging commenced 12-23-68 19
Plugging completed 12-28-68 19
Reason for abandonment of well or producing formation

If a producing well is abandoned, date of last production 19
Was permission obtained from the Conservation Division or its agents before plugging was commenced?

Name of Conservation Agent who supervised plugging of this well Ralph J. Warren
Producing formation Depth to top Bottom Total Depth of Well 4549' Feet
Show depth and thickness of all water, oil and gas formations.

OIL, GAS OR WATER RECORDS

CASING RECORD

FORMATION	CONTENT	FROM	TO	SIZE	PUT IN	PULLED OUT
				5 1/2"	4548'	2908.87'
				8 5/8"	261'	

Describe in detail the manner in which the well was plugged, indicating where the mud fluid was placed and the method or methods used in introducing it into the hole. If cement or other plugs were used, state the character of same and depth placed, from feet to feet for each plug set.

Made bottom hole plug back with sand to 4000', mixed and ran 5 sacks cement thru dump bailer.
Mudded hole to 260', set 10' rock bridge. Mixed and ran 25 sacks cement thru dump bailer. Mudded hole to 40', set 10' rock bridge. Mixed and dumped 10 sacks cement to base of cellar.

RECEIVED
STATE CORPORATION COMMISSION
JAN 6 1969
CONSERVATION DIVISION
Wichita, Kansas

(If additional description is necessary, use BACK of this sheet)

Name of Plugging Contractor Southwest Casing Pulling Co.
Address Box 364, Great Bend, Kansas


STATE OF Kansas, COUNTY OF Barton, ss.
Southwest Casing Pulling Co. (employee of owner) or (owner or operator) of the above-described well, being first duly sworn on oath, says: That I have knowledge of the facts, statements, and matters herein contained and the log of the above-described well as filed and that the same are true and correct. So help me God.

(Signature) W. C. Spencer Sec.
Box 364, Great Bend, Kansas
(Address)

SUBSCRIBER AND SWORN TO before me this 2 day of January, 19 69

Sidney D. Miller
Notary Public.

My commission expires

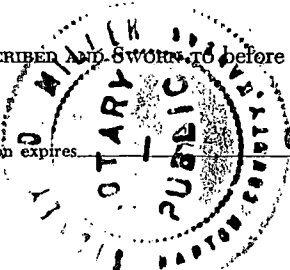

October 1972