

15-095-20427000


STATE OF KANSAS  
STATE CORPORATION COMMISSION  
CONSERVATION DIVISION  
P. O. BOX 17027  
WICHITA, KANSAS 67217

FORM CP-4

WELL PLUGGING RECORD

Kingman County, Sec. 19 Twp. 29S Rge. 6W (E) (W)  
Location as "NE/CNWSW" or footage from lines SW NW SE

Lease Owner PICKRELL DRILLING COMPANY  
Lease Name Cox "B" Well No. 4  
Office Address 705 4th National Bank Bldg., Wichita, Ks. 67202  
Character of Well (completed as Oil, Gas or Dry Hole) Dry Hole  
Date well completed 9-12-75 19  
Application for plugging filed 9-12-75 19  
Application for plugging approved 9-12-75 19  
Plugging commenced 9-12-75 19  
Plugging completed 9-12-75 19  
Reason for abandonment of well or producing formation Dry Hole

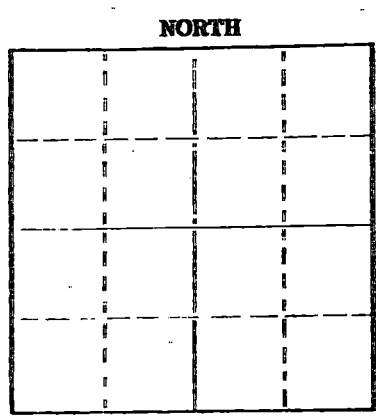

Locate well correctly on above Section Flat

If a producing well is abandoned, date of last production 19  
Was permission obtained from the Conservation Division or its agents before plugging was commenced? Yes

Name of Conservation Agent who supervised plugging of this well G. R. Biberstein  
Producing formation \_\_\_\_\_ Depth to top \_\_\_\_\_ Bottom \_\_\_\_\_ Total Depth of Well 4175 Feet  
Show depth and thickness of all water, oil and gas formations.

OIL, GAS OR WATER RECORDS

CASING RECORD

FORMATION	CONTENT	FROM	TO	SIZE	PUT IN	PULLED OUT
				8 5/8	200	None

Describe in detail the manner in which the well was plugged, indicating where the mud fluid was placed and the method or methods used in introducing it into the hole. If cement or other plugs were used, state the character of same and depth placed, from \_\_\_\_\_ feet to \_\_\_\_\_ feet for each plug set.

RECEIVED  
STATE CORPORATION COMMISSION  
OCT 2 1975  
CONSERVATION DIVISION  
Wichita, Kansas

35 sacks @ 200'  
15 sacks @ 40'  
2 sacks in Rat hole  
Comp. 8:30PM 9-12-75

(If additional description is necessary, use BACK of this sheet)  
Name of Plugging Contractor Pickrell Drilling Company  
Address 705 4th National Bank Bldg., Wichita, Ks. 67202

STATE OF Kansas COUNTY OF Sedgwick ss.  
C. W. Sebitts (employee of owner) or (owner or operator) of the above-described well, being first duly sworn on oath, says: That I have knowledge of the facts, statements and matters herein contained and the log of the above-described well as filed and that the same are true and correct. So help me God.

(Signature) C. W. Sebitts  
705 4th National Bank Bldg., Wichita, Ks. 67202  
(Address)

SUBSCRIBED AND SWORN TO before me this 29 day of Sept. 19 75

Helen L. Martin  
Notary Public.

My commission expires \_\_\_\_\_  
HELEN L. MARTIN  
Sedgwick County, Ks.  
My Appmt. Exp. Aug. 19, 1979

ROTARY DRILLING LOG

15-095-20427000

COMPANY: PICKRELL DRILLING COMPANY  
705 4th National Bank Bldg.  
Wichita, Ks. 67202  
LOCATION: Cox "B" #4  
SW NW SE 19-29S-6W  
Kingman Co., Ks.

Rotary Drilling Commenced 9-3-75  
Rotary Drilling Completed 9-12-75

CONTRACTOR: **PICKRELL DRILLING COMPANY**  
Wichita, Kansas

CASING RECORD: 8 5/8" surface casing @ 200' with 175 sacks cement. Comp. 9-3-75  
@ 9:30PM

LOG

(Figures indicate bottom of formation — measurements from top of rotary bushing.)

Top soil & sand	41
Red Beds	205
Red Beds & Shale	365
Red Beds & Shale	502
Shale & Shell	1045
Shale & Lime stks	1085
Shale w/lime stks	1425
Shale w/lime stks	1563
Lime & Shale	1700
Lime & Shale	1930
Lime & Shale	2110
Lime & Shale	2345
Lime & Shale	2555
Lime & Shale	2785
Shale w/Lime	2900
Shale & Lime	3100
Shale, Lime & Sand	3295
Lime	3415
Lime	3505
Lime-Shale	3610
Lime	3727
Lime	3800
Lime & Shale	3811
Lime & Shale	3920
Lime & Shale	3998
Lime & Shale	4035
Lime & Shale	4115
Chert	4135
Chert	4145
Chert - RTD	4175

RECEIVED  
STATE CORPORATION COMMISSION  
  
OCT 2 1975  
  
CONSERVATION DIVISION  
Wichita, Kansas

The undersigned, C. W. Sebits, Attorney-in-Fact for PICKRELL DRILLING COMPANY, hereby certifies in behalf of said Company, that the above is a true and correct log of the formation encountered in drilling the above well as reflected by the Daily Drilling Reports.

PICKRELL DRILLING COMPANY  
By [Signature]  
C. W. Sebits Attorney-in-Fact

STATE OF KANSAS }  
COUNTY OF SEDGWICK } ss.:

On this 29 day of Sept., 1975, before me the undersigned, a Notary Public, in and for

the County and State aforesaid, personally appeared C. W. SEBITS, to me known to be the identical person who subscribed the name of PICKRELL DRILLING COMPANY to the foregoing instrument as its Attorney-in-Fact and acknowledged to me that he executed the same as his free and voluntary act and deed, and as the free and voluntary act and deed of such company, for the uses and purposes therein set forth.

Given under my hand and seal of office the day and year last above written.

My commission expires:

STATE NOTARY PUBLIC  
HELEN L. MARTIN  
Sedgwick County, Ks.  
My Appmt. Exp. Aug. 19, 1979

[Signature]  
Helen L. Martin Notary Public