


WELL PLUGGING RECORD 15-095-30262-0000

Give All Information Completely  
Make Required Affidavit  
Mail or Deliver Report to:  
Conservation Division  
State Corporation Commission  
211 No. Broadway  
Wichita, Kansas

NORTH

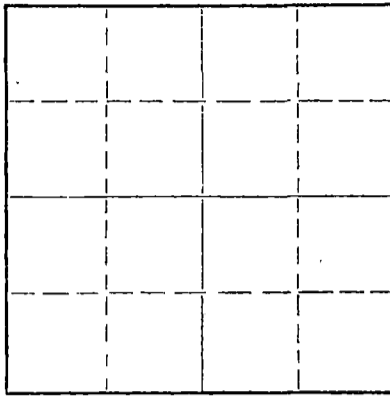

Locate well correctly on above  
Section Plat

Kingman County. Sec. 14 Twp. 29 Rge. 6 (E) W (W)  
Location as "NE/CNW/SW" or footage from lines C NE SW

Lease Owner Tom Kat, Inc.

Lease Name Sour Well No. 1

Office Address 1127 Wichita Plaza Bldg., Wichita, Ks.

Character of Well (completed as Oil, Gas or Dry Hole) D & A

Date well completed November 5 19 66

Application for plugging filed 11/5 19 66

Application for plugging approved 11/5 19 66

Plugging commenced 11/5 19 66

Plugging completed 11/5 19 66

Reason for abandonment of well or producing formation no commercial quantities of oil or gas produced

If a producing well is abandoned, date of last production 19

Was permission obtained from the Conservation Division or its agents before plugging was commenced? yes

Name of Conservation Agent who supervised plugging of this well Archie Elving

Producing formation Depth to top Bottom Total Depth of Well 4520 Feet

Show depth and thickness of all water, oil and gas formations.

OIL, GAS OR WATER RECORDS

CASING RECORD

FORMATION	CONTENT	FROM	TO	SIZE	PUT IN	PULLED OUT
Surface				8 5/8"	235	NONE

Describe in detail the manner in which the well was plugged, indicating where the mud fluid was placed and the method or methods used in introducing it into the hole. If cement or other plugs were used, state the character of same and depth placed, from feet to feet for each plug set.

Mud put in hole from 4520' to a depth of 225' - 25 sacks cement, mud to 40' - 10 sacks cement.

RECEIVED  
STATE CORPORATION COMMISSION  
NOV 28 1966  
11-28-66  
CONSERVATION DIVISION  
Wichita, Kansas

(If additional description is necessary, use BACK of this sheet)

Name of Plugging Contractor Tom Kat, Inc.  
Address 1127 Wichita Plaza, Wichita, Kansas

STATE OF KANSAS, COUNTY OF SEDGWICK, ss.  
Don G. Calvin (employee of owner) of the above-described well, being first duly sworn on oath, says: That I have knowledge of the facts, statements, and matters herein contained and the log of the above-described well as filed and that the same are true and correct. So help me God.

(Signature) Don G. Calvin

1127 Wichita Plaza, Wichita, Kansas  
(Address)

SUBSCRIBED AND SWORN TO before me this 21st day of November, 1966

My commission expires April 16, 1969

Caroline J. Scott  
Notary Public.

DRILLERS LOG

#1 SOURS

C NE SW, 14-29-6W

Kingman County, Kansas

FROM	TO	
0	230	Shale-Red Bed
230	243	Shale
243	976	Shale-Red Bed-Sand
976	1045	Anhydrite
1045	1095	Shale & shells
1095	2680	Shale & lime
2680	2825	Lime & shale
2825	3291	Shale & lime
3291	3515	Lime & shale
3515	3770	Lime
3770	3880	Lime & shale
3880	4075	Shale & lime
4075	4085	Lime & shale
4085	4103	Lime-chert
4103	4118	Lime
4118	4240	Lime & chert
4240	4318	Lime
4318	4360	Lime & shale
4360	4456	Shale & lime
4456	4465	Lime
4465	4490	Lime & sand
4490	4520	Sand & shale
	4520	Rotary total depth

RECEIVED  
 STATE CORPORATION COMMISSION  
 NOV 28 1966  
 CONSERVATION DIVISION  
 Wichita, Kansas

\*\*\*\*\*

REMARKS

Set 234 feet of 8 5/8" surface casing with 225 sacks cement.

\*\*\*\*\*

TOPS(Electric log)

Heebner	2994 (-1470)	Mississippian	4086 (-2562)
Brown lime	3248 (-1724)	Kinderhook	4344 (-2820)
Lansing	3278 (-1754)	Maquoketa shale	4438 (-2914)
Kansas City	3514 (-1990)	Viola	4458 (-2934)
Base K. C.	3760 (-2236)	Simpson Dolomite	4479 (-2955)
		Total depth	4524

I certify to the best of my knowledge and belief, the above represents a true and accurate driller's log record of the captioned well.

Don Calvin

STATE OF KANSAS

SS

COUNTY OF SEDGWICK

Subscribed and sworn to before me this 21<sup>st</sup> day of November, 1966.

My commission expires: April 16, 1969

Barbara J. Scott