


STATE OF KANSAS  
STATE CORPORATION COMMISSION

15-155-20572-0000

WELL PLUGGING RECORD

Give All Information Completely  
Make Required Affidavit  
Mail or Deliver Report to  
Conservation Division  
State Corporation Comm.  
245 North Water  
Wichita, KS 67202

Reno County. Sec. 4 Twp. 23S Rge. 9 E/W  
Location as "NE/CNW 1/4 SW 1/4" or footage from lines  
C W/2 Sw/4  
Lease Owner Rudy A. Herman  
Lease Name Hill Well No. # 1  
Office Address P. O. Box 348 Great Bend, Ks. 67530  
Character of Well (Completed as Oil, Gas or Dry Hole)

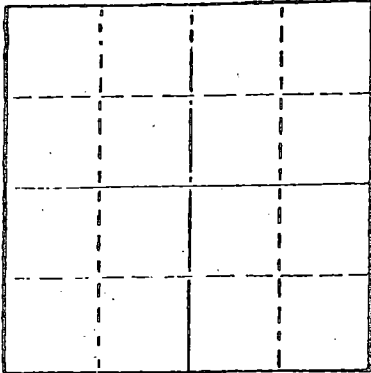

Locate well correctly on above  
Section Plat

dry hole  
Date Well completed January 24 1979  
Application for plugging filed January 24 1979  
Application for plugging approved January 24 1979  
Plugging commenced January 24 1979  
Plugging completed January 24 1979  
Reason for abandonment of well or producing formation

dry hole  
If a producing well is abandoned, date of last production 19

Was permission obtained from the Conservation Division or its agents before plugging was commenced? yes

Name of Conservation Agent who supervised plugging of this well Gilbert Toman  
Producing formation Depth to top Bottom Total Depth of Well 3628  
Show depth and thickness of all water, oil and gas formations.

OIL, GAS OR WATER RECORDS

CASING RECORD

FORMATION	CONTENT	FROM	TO	SIZE	PUT IN	PULLED OUT

Describe in detail the manner in which the well was plugged, indicating where the mud fluid was placed and the method or methods used in introducing it into the hold. If cement or other plugs were used, state the character of same and depth placed, from feet to feet for each plug set.

Start to plug hole @ 1:00 P. M.,  
Set bottom plug @ 500' w/40 sacks 60/40 Poz. 4% Gel. thru D.P. by Allied.  
# 2 plug @ 275' w/25 sacks thru D.P.  
Top plug @ 40' w/1/2 sacks hulls for solid bridge & 10 sacks cement, 2 sacks in rathole.

RECEIVED  
STATE CORPORATION COMMISSION

JAN 29 1979 1-29-79

(If additional description is necessary, use BACK OF THIS SHEET)

Name of Plugging Contractor Duke Drilling Co., Inc. Wichita, Kansas

STATE OF Kansas COUNTY OF Barton, ss.  
Bill Draney (employee of owner) or (owner or operator)  
of the above-described well, being first duly sworn on oath, says: That I have knowledge of the facts, statements, and matters herein contained and the log of the above-described well as filed and that the same are true and correct. So help me God.

(Signature) Bill Draney

(Address)

SUBSCRIBED AND SWORN TO before me this 25th day of January, 1979

Dorothy M. Sague Notary Public.

My commission expires April 11, 1982



DRILLERS' WELL LOG

15-155-20572-0000

DATE COMMENCED: January 16, 1979  
DATE COMPLETED: January 24, 1979

Rudy Harmon  
Hill # 1  
O W/2 SW/4  
Sec. 4, T23S, R21W  
Hemp County, Ks.

0 - 100'	Surface Soil & Sand
100 - 286'	Shale & Redbed
286 - 1030'	Redbed & Shale
1030 - 3012'	Shale & Lime
3012 - 3017'	Shale
3017 - 3038'	Lime & Shale
3038 - 3172'	Shale
3172 - 3202'	Lime & Shale
3202 - 3524'	Lime
3524 - 3628'	Lime, Shale, Chert
3628'	KUD

Elevation: 1795 K.S.

<u>Formation</u>	<u>Date</u>
Neomer	3012'
Douglas	3038'
Brown Lime	3172'
Lansing- K.C.	3202'
Base- K.C.	3524'
Marnston	3539'
Gonglen-etc	3549'
Mississippi	3580'
Kinderhook Shale	3618'
R. T. D.	3628'

Surface Pipe: Set new  
8 5/8" pipe at 286'  
w/225 sacks 60/40 pozzist,  
2% gel, 3% cc.

AFFIDAVIT

STATE OF KANSAS  
HEMP COUNTY) ss

Bill Draney, of lawful age does swear and state that the facts and statements here in contained are true and correct to the best of his knowledge.

Bill Draney

Subscribed and sworn to before me on this 25 day of January 19 79

My Comm. Expires  
April 11, 1982

Alonzo M. Sague  
Notary Public

RECEIVED  
STATE CORPORATION COMMISSION

JAN 29 1979

COMMISSION DIVISION