


Give All Information Completely  
Make Required Affidavit  
Mail or Deliver Report to:  
Conservation Division  
State Corporation Commission  
211 No. Broadway  
Wichita, Kansas

WELL PLUGGING RECORD

NORTH

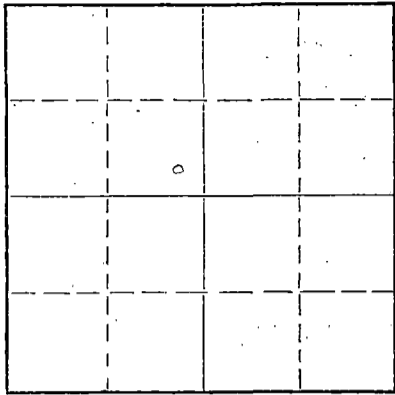

Locate well correctly on above  
Section Plat

Reno County, Sec. 2 Twp. 23 Rge. 9 (E) W (W)  
Location as "NE/CNWSW" or footage from lines SE SE NW  
Lease Owner Ambassador Oil Corp  
Lease Name S. O. Roth Well No. 1  
Office Address Hightower Bldg., Oklahoma City, Oklahoma  
Character of Well (completed as Oil, Gas or Dry Hole) Dry Hole  
Date well completed June 26 19 57  
Application for plugging filed " 26 19 57  
Application for plugging approved " 26 (verbally) 19 57  
Plugging commenced " 26 19 57  
Plugging completed " 26 19 57  
Reason for abandonment of well or producing formation Dry Hole

If a producing well is abandoned, date of last production \_\_\_\_\_ 19 \_\_\_\_  
Was permission obtained from the Conservation Division or its agents before plugging was commenced? Yes

Name of Conservation Agent who supervised plugging of this well R. M. Brundege, Hoisington, Kansas  
Producing formation \_\_\_\_\_ Depth to top \_\_\_\_\_ Bottom \_\_\_\_\_ Total Depth of Well 3910 Feet  
Show depth and thickness of all water, oil and gas formations.

OIL, GAS OR WATER RECORDS

CASING RECORD

| FORMATION | CONTENT | FROM | TO   | SIZE   | PUT IN | PULLED OUT |
|-----------|---------|------|------|--------|--------|------------|
| Surface   |         |      | 212' | 8 5/8" | 212'   | None       |
|           |         |      |      |        |        |            |
|           |         |      |      |        |        |            |
|           |         |      |      |        |        |            |
|           |         |      |      |        |        |            |

Describe in detail the manner in which the well was plugged, indicating where the mud fluid was placed and the method or methods used in introducing it into the hole. If cement or other plugs were used, state the character of same and depth placed, from \_\_\_\_\_ feet to \_\_\_\_\_ feet for each plug set.

Filled hole with mud from total depth to 200' with plug and 20 sacks of cement at this point. Heavy mud to 35' with plug and 10 sacks of cement at this point.

RECEIVED  
STATE CORPORATION COMMISSION

JUN 28 1957

CONSERVATION DIVISION  
Wichita, Kansas

6-28-57

(If additional description is necessary, use BACK of this sheet)  
Name of Plugging Contractor Harms-Burt Drilling Company  
Address Box 184, Great Bend, Kansas

STATE OF Kansas, COUNTY OF Barton, ss.  
Allan Harms (employee of owner) or (owner or operator) of the above-described well, being first duly sworn on oath, says: That I have knowledge of the facts, statements, and matters herein contained and the log of the above-described well as filed and that the same are true and correct. So help me God.

(Signature) Allan Harms  
Box 184, Great Bend, Kansas  
(Address)

SUBSCRIBED AND SWORN TO before me this 27 day of June, 19 57  
Mary E Van Pelt  
Notary Public.

My commission expires 1-20-58

PLUGGING  
FILE SEC 2 T. 23 R. 9W  
BOOK PAGE 24 LINE 11

DRILLERS LOG

15-155-00195-0000

Company: Ambassador Oil Corp.

SE SE NW Section 2-23S-9W

Farm: S. O. Roth #1

Reno County, Kansas

Commenced: June 13, 1957

Completed: June 26, 1957

Elevation: 1718 KB

0 - 30 clay  
 30 - 135 sand  
 135 - 350 red bed  
 350 - 1250 shale & shells  
 1250 - 1570 Shale & lime  
 1570 - 1880 lime & shale  
 1880 - 1970 shale & lime  
 1970 - 2080 lime & shale  
 2080 - 2690 shale & lime  
 2690 - 2915 lime & shale  
 2915 - 2999 lime  
 2999 - 3186 shale & lime  
 3186 - 3658 lime  
 3658 - 3750 shale  
 3750 - 3777 shale & lime  
 3777 - 3781 sand  
 3781 - 3801 Viola  
 3801 - 3875 Simpson  
 3875 - 3892 lime & chert  
 3892 - 3910 Arbuckle  
 3910 T.D.

Set 212' of 8 5/8" surface pipe. Cemented with 200 sacks of common cement and 2 sacks of calcium chloride. Cement circulated.

Tops: Heebner - 2999  
 Br. Lime - 3147  
 Lansing - 3186  
 Kinderhook - 3658  
 Misner - 3777  
 Viola - 3781  
 Simpson - 3801  
 Arbuckle - 3892

RECEIVED  
 STATE CORPORATION COMMISSION

JUN 28 1957

CONSERVATION DIVISION  
 Wichita, Kansas

Drill Stem Tests: #1 -3257 Shut in 20 min. Open 1 hour. Shut in 20 min. Recovered 9' mud. IHH-1770#  
 IBOP 1195, FFPO FHH 1730#

Ran Electric log.

Dry, plugged and abandoned.

AFFIDAVIT

State of Kansas )  
 ) SS.  
 County of Barton)

I, Allan Harms, of Harms-Burt Drilling Company, being first duly sworn on oath state: I have knowledge of the facts, statements, and matters herein contained and the same are true and correct.

*Allan Harms*

Subscribed and sworn to before me this 27 day of June 1957

*Mary E Van Pelt*  
 Notary Public

My commission expires Jan. 20, 1958.

PLUGGING  
 FILE SEC. 2 T. 23 R. 9W  
 BOOK PAGE 24 LINE 11