

Give All Information Completely  
Make Required Affidavit  
Mail or Deliver Registered  
Conservation Division  
State Corporation Commission  
211 No. Broadway  
Wichita, Kansas


WELL PLUGGING RECORD

15-155-60417-0000

Reno County, Sec. 1 Twp. 23S Rge. 9 (E) W (W)

Location as "NE/CNW&SW&" or footage from lines. SE NW  
Lease Owner Beardmore Drilling Co.  
Lease Name Zimmerman Well No. 1  
Office Address 827 Beacon Bld'g., Wichita, Kansas  
Character of Well (completed as Oil, Gas or Dry Hole) Dry Hole  
Date well completed 6-21 19 64  
Application for plugging filed 6-21 19 64  
Application for plugging approved 6-21 19 64  
Plugging commenced 6-21 19 64  
Plugging completed 6-21 19 64  
Reason for abandonment of well or producing formation Dry Hole

NORTH

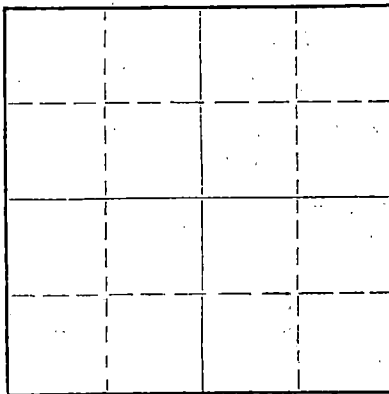

Locate well correctly on above  
Section Plat

If a producing well is abandoned, date of last production \_\_\_\_\_ 19\_\_\_\_  
Was permission obtained from the Conservation Division or its agents before plugging was commenced? yes

Name of Conservation Agent who supervised plugging of this well Archie Elving Pratt, Kansas  
Producing formation \_\_\_\_\_ Depth to top \_\_\_\_\_ Bottom \_\_\_\_\_ Total Depth of Well 3720 Feet  
Show depth and thickness of all water, oil and gas formations.

OIL, GAS OR WATER RECORDS

CASING RECORD

FORMATION	CONTENT	FROM	TO	SIZE	PUT IN	PULLED OUT
Surface soil & sand		0	80'			
Red Beds		80'	300'			
			300'	8 5/8"	300'	-0-

Describe in detail the manner in which the well was plugged, indicating where the mud fluid was placed and the method or methods used in introducing it into the hole. If cement or other plugs were used, state the character of same and depth placed, from \_\_\_\_\_ feet to \_\_\_\_\_ feet for each plug set.

0 to 40' - 10 sacks cement  
40' - wood plug  
40' to 165' - heavy mud  
165' to 240' - 25 sacks cement  
240' - wood plug  
240' to 3720' - heavy mud

RECEIVED  
STATE CORPORATION COMMISSION

JUN 29 1964

CONSERVATION DIVISION  
Wichita, Kansas

Also 2 sacks cement in rat hole

(If additional description is necessary, use BACK of this sheet)

Name of Plugging Contractor Gabbert-Jones, Inc.  
Address 514 Oppheim Bld'g., Wichita, Kansas

STATE OF Kansas, COUNTY OF Sedgwick, ss.  
Heber Beardmore (employee of owner) or (owner or operator) of the above-described well, being first duly sworn on oath, says: That I have knowledge of the facts, statements, and matters herein contained and the log of the above-described well as filed and that the same are true and correct. So help me God.

(Signature) Heber Beardmore

827 Beacon Bld'g., Wichita, Kansas

(Address)

SUBSCRIBED AND SWORN to before me this 25th day of June, 1964

My commission expires July 13, 1967

Shirley Ann Jackson  
Shirley Ann Jackson

Notary Public.



GABBERT-JONES, INC.  
 WICHITA, KANSAS  
 DRILLER'S WELL LOG

15-155-00417-0000

Zimmerman #1  
 Center SE NW Section 1-23-9W  
 Reno County, Kansas

Date Commenced - 6-12-64  
 Date Completed - 6-21-64

OPERATOR: BEARDMORE DRILLING COMPANY

DEPTH		FORMATION	REMARKS
From	To		
0	80	Surface Soil/Sand	
80	300	Red Bed	
300	1215	Red Bed/Shale	Ran 300' of 8-5/8" cemented w/200 sx common cement
1215	1450	Shale/Lime	
1450	1608	Lime/Shale	
1608	1710	Shale/Shells	
1710	1865	Shale/Lime	
1865	2000	Shale/Lime	
2000	2285	Lime/Shale	
2285	2485	Shale/Lime	
2485	2640	Lime/Shale	
2640	2845	Lime/Shale	
2845	2975	Lime/Shale	
2975	3085	Lime/Shale	
3085	3245	Shale/Lime	
3245	3320	Lime/Shale	
3320	3367	Lime/Shale	
3367	3440	Lime	
3440	3529	Lime	
3529	3597	Lime	
3597	3670	Lime/Shale	
3670	3680	Lime	
3680	3707	DST #1	
3707	3720	Lime	
3720		Total Depth	Dry & Abandoned

RECEIVED  
 STATE CORPORATION COMMISSION  
 JUN 29 1964  
 CONSERVATION DIVISION  
 Wichita, Kansas

I, E. E. HALL, certify that this is a true and correct copy of the Driller's Log for the well drilled in the Center SE NW Section 1-23-9W, Reno County, Kansas, to the best of my knowledge and belief.

E. E. Hall

STATE OF KANSAS )  
 ) ss:  
 SEDGWICK COUNTY )

Before me this day, June 23, 1964, personally appeared E. E. Hall, to me personally known to be the identical person who executed the within and foregoing instrument and acknowledged to me that he executed the same as his free and voluntary act and deed for the uses and purposes therein set forth.

IN WITNESS WHEREOF, I have hereunto set my hand and official seal the day and year last above written.

Vera A. McKenzie  
 Vera A. McKenzie, Notary Public

My Commission expires October 2, 1967