


Give All Information Completely  
Make Required Affidavit  
Mail or Deliver Report to:  
Conservation Division  
State Corporation Commission  
211 No. Broadway  
Wichita, Kansas

WELL PLUGGING RECORD

Reno County, Sec. 14 Twp. 23S Rge. 9W (E) (W)

Location as "NE/CNW/SW" or footage from lines C SW NE  
Lease Owner Solar Oil Company  
Lease Name Schrock Well No. 2  
Office Address 1117 Union National Building Wichita, Kansas  
Character of Well (completed as Oil, Gas or Dry Hole) Dry Hole  
Date well completed May 1 19 66  
Application for plugging filed May 1 19 66  
Application for plugging approved May 1 19 66  
Plugging commenced May 1 19 66  
Plugging completed 9:30 a.m. May 1 19 66  
Reason for abandonment of well or producing formation Dry Hole

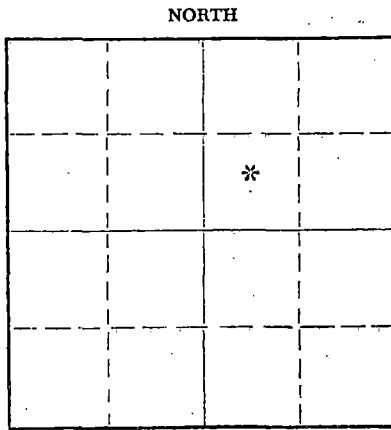

Locate well correctly on above Section Plat

If a producing well is abandoned, date of last production 19  
Was permission obtained from the Conservation Division or its agents before plugging was commenced? Yes

Name of Conservation Agent who supervised plugging of this well Hue Scott  
Producing formation Depth to top Bottom Total Depth of Well 3734 Feet  
Show depth and thickness of all water, oil and gas formations.

OIL, GAS OR WATER RECORDS

CASING RECORD

FORMATION	CONTENT	FROM	TO	SIZE	PUT IN	PULLED OUT
Surface Pipe		0	210'	8 5/8"	210'	None

Describe in detail the manner in which the well was plugged, indicating where the mud fluid was placed and the method or methods used in introducing it into the hole. If cement or other plugs were used, state the character of same and depth placed, from feet to feet for each plug set.

Filled hole with heavy mud.  
Plug # 1 at 200' with 25 sacks cement.  
Plug # 2 at 40' with 10 sacks cement.  
Plug # 3 in rathole with 2 sacks cement.  
Completed at 9:30 a.m. May 1.

RECEIVED  
STATE CORPORATION COMMISSION

MAY 12 1966

5-12-66

(If additional description is necessary, use BACK of this sheet)  
Name of Plugging Contractor S & S Drilling Company  
Address Box 645 Great Bend, Kansas

STATE OF Kansas, COUNTY OF Barton, ss.  
T. D. Sweetman (employee of owner) or (owner/operator) of the above-described well, being first duly sworn on oath, says: That I have knowledge of the facts, statements, and matters herein contained and the log of the above-described well as filed and that the same are true and correct. So help me God.

(Signature) T. D. Sweetman  
Box 645 Great Bend, Kansas  
(Address)

SUBSCRIBED AND SWORN TO before me this 2nd day of May, 19 66

My commission expires 5/9/67

Leata S. Boyd Notary Public.

15-155-30106-0000

WELL LOG  
Schrock # 2 23  
C SW NE Sec. 11-25-94  
Reno County, Kansas

<u>From</u>	<u>To</u>		<u>Elevation:</u>
0	110	Clay and Sand	1720' K.B.
110	210	Red Bed	
210	330	Red Bed	<u>Formation Tops:</u>
330	1120	Shale, Shells with Salt and Red Bed	Mississippi 3730'
1120	1145	Lime and shale	
1145	1605	Shale and Lime	
1605	2010	Lime and Shale	
2010	2225	Shale and Lime	
2225	2735	Lime and Shale	
2735	2760	Lime	
2760	2920	Lime and Shale	
2920	3085	Lime	
3085	3190	Shale and Lime	
3190	3217	Shale	
3217	3230	Lime	
3230	3285	Shale and Lime	
3285	3590	Lime	
3590	3675	Lime and Shale	
3675	3718	Lime	
3718	3730	Lime and Shale	
3730	3734	Chert Mississippi	
3734		Total Depth	

RECEIVED  
STATE CORPORATION COMMISSION  
MAY 5 - 1966  
CONSERVATION DIVISION

STATE OF KANSAS  
COUNTY OF BARTON ss

T. D. Sweetman, Partner of S & S Drilling Company, being first duly sworn on oath says: That I have knowledge of the facts, statements and matters herein contained and the log of the above described well as filed and that the same are true and correct.

T. D. Sweetman

Subscribed and sworn before me this 2nd day of May, 1966.

Reata L. Boyd  
Notary Public Barton County

My Commission Expires: 5/9/67