


WELL PLUGGING RECORD

Give All Information Completely  
Make Required Affidavit  
Mail or Deliver Report to:  
Conservation Division  
State Corporation Commission  
212 North Market, Insurance Bldg.  
Wichita, Kansas

Reno County. Sec. 14 Twp. 23 Rge. 9 (E) (W)  
Location as "NE/CNW/SW" or footage from lines SE $\frac{1}{4}$  NE $\frac{1}{4}$  SE $\frac{1}{4}$   
Lease Owner Solar Oil Company  
Lease Name Oyer Well No. 1  
Office Address 1117 Union National Building, Wichita, Kansas  
Character of Well (completed as Oil, Gas or Dry Hole) D & A  
Date well completed May 2 19 62  
Application for plugging filed May 2 19 62  
Application for plugging approved May 2 19 62  
Plugging commenced May 2 19 62  
Plugging completed May 2 19 62  
Reason for abandonment of well or producing formation Dry & Abandoned

NORTH

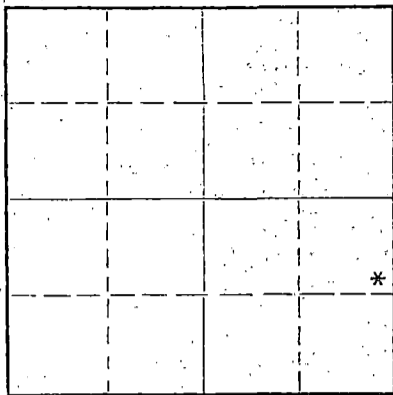

Locate well correctly on above  
Section Plat

If a producing well is abandoned, date of last production 19  
Was permission obtained from the Conservation Division or its agents before plugging was commenced? Yes

Name of Conservation Agent who supervised plugging of this well Mr. Lackamp Stafford, Kansas  
Producing formation Depth to top Bottom Total Depth of Well 3808 Feet  
Show depth and thickness of all water, oil and gas formations.

OIL, GAS OR WATER RECORDS

CASING RECORD

FORMATION	CONTENT	FROM	TO	SIZE	PUT IN	PULLED OUT
Surface		0	236	8 5/8	236	

Describe in detail the manner in which the well was plugged, indicating where the mud fluid was placed and the method or methods used in introducing it into the hole. If cement or other plugs were used, state the character of same and depth placed, from feet to feet for each plug set.

Filled with mud to 220'.  
Pushed plug to 220' with 1/4 sack hulls  
Cemented with 35 sacks  
Pushed plug to 35' with 1/4 sack hulls  
Cemented to surface with 10 sacks.

RECEIVED  
STATE CORPORATION COMMISSION

MAY 15 1962 5-16-62

CONSERVATION DIVISION  
Wichita, Kansas

(If additional description is necessary, use BACK of this sheet)

Name of Plugging Contractor S & S Drilling Company  
Address P. O. Box 339, Great Bend, Kansas

STATE OF Kansas, COUNTY OF Barton, ss.  
T. D. Sweetman (employee of owner) or (owner or operator) of the above-described well, being first duly sworn on oath, says: That I have knowledge of the facts, statements, and matters herein contained and the log of the above-described well as filed and that the same are true and correct. So help me God.

(Signature) T. D. Sweetman

Box 339, Great Bend, Kansas  
(Address)

SUBSCRIBED AND SWORN TO before me this 14th day of May, 19 62

Jean Kimber

Notary Public.

My commission expires 12-3-63



W E L L L O G  
 Oyer # 1  
 SE NE SE 14-23-9  
Reno County, Kansas

15-155-02016-0000

<u>From</u>	<u>To</u>		<u>Elevation</u>	<u>1710 D.F.</u>
0	170	Surface Sand	Heebner	3056
170	240	Red Bed	Kansas City	3240
240	1150	Shale & Shells	Conglomerate	3716
1150	1500	Sand & Shale	Mississippi	3742
1500	3184	Lime & Shale	Kinderhook	3801
3184	3245	Douglas Shale		
3245	3494	Lime		
3494	3803	Lime & Shale		
3803	3808	Lime		
3808		T. D.		

**RECEIVED**  
 STATE CORPORATION COMMISSION  
 MAY 16 1962  
 CONSERVATION DIVISION  
 Wichita, Kansas

STATE OF KANSAS

COUNTY OF BARTON ss

T. D. Sweetman, Partner of S & S Drilling Company, being first duly sworn on oath says: That I have knowledge of the facts, statements and matters herein contained and the log of the above described well as filed and that the same are true and correct.

T. D. Sweetman

Subscribed and sworn before me this 8th day of May, 1962.

Jean Kimber  
 Notary Public Barton County