


STATE OF KANSAS
STATE CORPORATION COMMISSION
Give All Information Completely
Make Required Affidavit
Mail or Deliver Report to:
Conservation Division
State Corporation Commission
800 Bitting Building
Wichita, Kansas

WELL PLUGGING RECORD

Reno County, Sec. 13 Twp. 23 S Rge. (E) 9 (W)

Location as "NE/CNW4SW4" or footage from lines SW SE SW
Lease Owner Ambassador Oil Corporation
Lease Name E. L. Oyer Well No. 1
Office Address 304 Hightower Building, Oklahoma City, Oklahoma
Character of Well (completed as Oil, Gas or Dry Hole) Oil
Date well completed 10-18-56 19__
Application for plugging filed June 14, 1962 19__
Application for plugging approved June 15, 1962 19__
Plugging commenced August 11, 1962 19__
Plugging completed August 17, 1962 19__
Reason for abandonment of well or producing formation
uneconomical
If a producing well is abandoned, date of last production 6-8-62 19__
Was permission obtained from the Conservation Division or its agents before plugging was commenced? yes

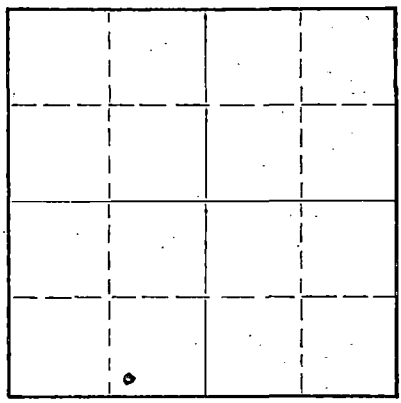

Locate well correctly on above Section Plat

Name of Conservation Agent who supervised plugging of this well Herman Justus
Producing formation Conglomerate Depth to top 3698 Bottom 3708 Total Depth of Well 3745 Feet
Show depth and thickness of all water, oil and gas formations.

OIL, GAS OR WATER RECORDS

CASING RECORD

FORMATION	CONTENT	FROM	TO	SIZE	PUT IN	PULLED OUT
<u>Conglomerate</u>	<u>oil and gas</u>	<u>3706</u>	<u>3708</u>	<u>8-5/8</u> <u>5-1/2</u>	<u>198</u> <u>3745</u>	<u>left in hole</u> <u>2721'</u>

Describe in detail the manner in which the well was plugged, indicating where the mud fluid was placed and the method or methods used in introducing it into the hole. If cement or other plugs were used, state the character of same and depth placed, from _____ feet to _____ feet for each plug set.

Sand from 3745 to 3700. Dumped 4 sacks cement, pulled 2721' 5 1/2". Mudded hole with chunk mud to 200'. 10' rock bridge to 190'. Dumped 20 sx. cement to 130', mud to 40', then 10' rock bridge to 30'. Dumped 10' sacks cement to 0'.

RECEIVED
STATE CORPORATION COMMISSION
AUG 27 1962
CONSERVATION DIVISION
Wichita, Kansas
8-27-62

(If additional description is necessary, use BACK of this sheet)
Name of Plugging Contractor Ralph Comstock Pipe Pulling, Inc.
Address Stafford, Kansas Permit #490

STATE OF Oklahoma, COUNTY OF Oklahoma, ss.
Harold E. Burke (employee of owner) ~~or (owner or operator)~~ of the above-described well, being first duly sworn on oath, says: That I have knowledge of the facts, statements, and matters herein contained and the log of the above-described well as filed and that the same are true and correct. So help me God.

(Signature) Harold E. Burke Dist. Prod. Supt.
304 Hightower Bldg, Oklahoma City, Okla.
(Address)

SUBSCRIBED AND SWORN to before me this 23rd day of August, 19 62

My commission expires June 2, 1964
Peggy J. Southern Notary Public.

