

STATE OF KANSAS
STATE CORPORATION COMMISSION

15-077-20869-0000

WELL PLUGGING RECORD

Give All Information Completely
Make Required Affidavit
Mail or Deliver Report to
Conservation Division
State Corporation Comm.
245 North Water
Wichita, KS 67202

Harper County, Sec. 13 Twp. 32S Rge. 9 E/W
Location as "NE/CNW $\frac{1}{4}$ SW $\frac{1}{4}$ " or footage from lines
C SE SW

Lease Owner Hummon Corporation
Lease Name Yocam Well No. 1

Office Address 400 One Main Place, Wichita, Kansas 67202
Character of Well (Completed as Oil, Gas or Dry Hole)
Dry hole


Date Well completed 1/10/83 19
Application for plugging filed 1/10/83 19
Application for plugging approved 1/10/83 19
Plugging commenced 1/10/83 19
Plugging completed 1/10/83 19

Reason for abandonment of well or producing formation
Dry hole

If a producing well is abandoned, date of last production
19

Was permission obtained from the Conservation Division or
its agents before plugging was commenced? Yes

Name of Conservation Agent who supervised plugging of this well Steve Gilson, Kingman, KS
Producing formation Depth to top Bottom Total Depth of Well 4865
Show depth and thickness of all water, oil and gas formations.

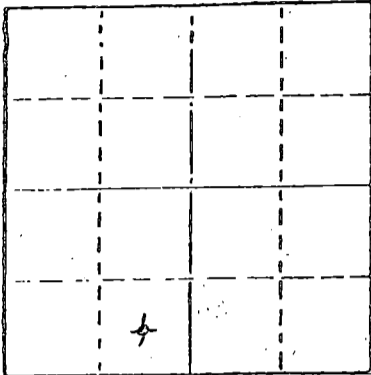

Locate well correctly on above
Section Plot

OIL, GAS OR WATER RECORDS

CASING RECORD

FORMATION	CONTENT	FROM	TO	SIZE	PUT IN	PULLED OUT
	Surface	0	225	8-5/8"	yes	no

Describe in detail the manner in which the well was plugged, indicating where the mud fluid was placed and the method or methods used in introducing it into the hold. If cement or other plugs were used, state the character of same and depth placed, from feet to feet for each plug set.

- 1st plug @ 950' w/ 40 sx.
- 2nd plug @ 275' w/ 35 sx.
- Bridge & plug @ 60' w/ 20 sx.
- 10 sx. in rathole
- 10 sx. in mousehole
- Job complete @ 7:30 p.m. 1/10/83

(If additional description is necessary, use BACK of this sheet)

Name of Plugging Contractor Big-H Drilling, Inc.

STATE OF KANSAS COUNTY OF SEDGWICK, ss.

Wilber Berg of Big-H Drilling, Inc. (employee of owner) or (owner or operator) of the above-described well, being first duly sworn on oath, says: That I have knowledge of the facts, statements, and matters herein contained and the log of the above-described well as filed and that the same are true and correct. So help me God.

(Signature) Wilber Berg
400 One Main Place, Wichita, KS 67202
(Address)

SUBSCRIBED AND SWORN TO before me this 20th day of January, 1983
SANDRA L. MENDOZA
STATE NOTARY PUBLIC
SEDGWICK COUNTY, KANSAS
MY APPT. EXP. 2/13/86
Notary Public.

My commission expires 2/13/86

RECEIVED
STATE CORPORATION COMMISSION

JAN 24 1983 1-24-83

CONSERVATION DIVISIO
Wichita Kansas

DRILLERS LOG

15-077-20869-0000

#1 Yocam

CASING RECORD:

8-5/8" @ 225'
w/ 175 sx. cement
Plugged & Abandoned

COMPANY: Hummon Corporation

CONTRACTOR: Big-H Drilling, Inc.

COMMENCED: December 31, 1982

COMPLETED: January 11, 1983

DESCRIPTION:

C SE SW Sec. 13-32S-9W
Harper County, Kansas

ELEVATION: 1510 KB

<u>FORMATION</u>	<u>FROM</u>	<u>TO</u>	<u>REMARKS</u>
Red Beds & Red Rock	0	230	
Shale	230	1275	
Shale & Lime	1275	1560	
Lime & Shale	1560	1821	
Shale & Lime	1821	2077	
Lime & Shale	2077	2604	
Shale & Lime	2604	3122	
Lime & Shale	3122	3368	
Shale & Lime	3368	3834	
Lime & Shale	3834	4024	
Shale & Lime	4024	4092	
Lime & Shale	4092	4269	
Shale & Lime	4269	4369	
Lime, Shale & Chert	4369	4435	
Dolomite & Chert	4435	4450	
Lime & Chert	4450	4459	
Lime, Chert & Shale	4459	4636	
Shale & Limer	4636	4715	
Lime & Shale	4715	4825	
Shale & Lime	4825	4865	
RTD		4865	

I certify that this is a true and correct copy of the above log to the best of my knowledge.

BIG-H DRILLING, INC.

Karen Tennis

Karen Tennis

Subscribed and sworn to before me this 18th day of January, 1983.

SANDRA L. MENDOZA
STATE NOTARY PUBLIC
SEDGWICK COUNTY, KANSAS
MY APPT. EXP. _____

Sandra L. Mendoza

Notary Public

RECEIVED
STATE CONTRACTUAL COMMISSION

JAN 24 1983

CONSERVATION DIVISION
Wichita Kansas