

STATE OF KANSAS
STATE CORPORATION COMMISSION

Give All Information Completely
Make Required Affidavit
Mail or Deliver Report to:
Conservation Division
State Corporation Commission
800 Bitting Building
Wichita, Kansas


WELL PLUGGING RECORD

OR 15.007.01545.00.00

FORMATION PLUGGING RECORD

Strike out upper line
when reporting plug-
ging off formations.

NORTH

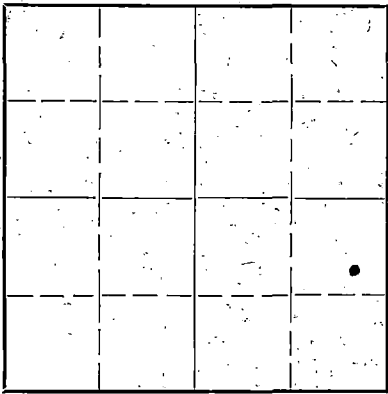

Locate well correctly on above
Section Plat

Barber County, Sec. 27 Twp. 30S Rge. (E) 15 (W)

Location as "NE $\frac{1}{4}$ NW $\frac{1}{4}$ SW $\frac{1}{4}$ " or footage from lines SE $\frac{1}{4}$ NE $\frac{1}{4}$ SE $\frac{1}{4}$

Lease Owner Great Lakes Carbon Corporation

Lease Name Massey "B" Well No. 3

Office Address 501 Petroleum Bldg., Wichita, Kansas

Character of Well (completed as Oil, Gas or Dry Hole) Dry Hole

Date well completed 10-20 19 46

Application for plugging filed 11-27 19 46

Application for plugging approved 12-5 19 46

Plugging commenced 1-31 19 47

Plugging completed 2-8 19 47

Reason for abandonment of well or producing formation Dry Hole

If a producing well is abandoned, date of last production - 19

Was permission obtained from the Conservation Division or its agents before plugging was com-
menced? Yes

Name of Conservation Agent who supervised plugging of this well H. W. Kerr - Great Bend, Kansas

Producing formation - Depth to top - Bottom - Total Depth of Well 4363 Feet

Show depth and thickness of all water, oil and gas formations.

OIL, GAS OR WATER RECORDS

CASING RECORD

Formation	Content	From	To	Size	Put In	Pulled Out
None		None				

Describe in detail the manner in which the well was plugged, indicating where the mud fluid was placed and the method or methods used in introducing it into the hold. If cement or other plugs were used, state the character of same and depth placed, from _____ feet to _____ feet for each plug set.

4363' to 3410' Rock and mud.
3410' to 3400' Cement, 5 sax.
3400' to 350' Mud
350' to 325' Cement, 15 sax.
325' to 10' Mud
10' to Bottom of cellar - Cement, 10 sax

PLUGGING
FILE SEC 27 T 30 R 15
BOOK PAGE 83 LINE 45

FEB 13 1947

2-13-47

Correspondence regarding this well should be addressed to Great Lakes Carbon Corporation
Address 501 Petroleum Bldg., Wichita, Kansas.

STATE OF KANSAS, COUNTY OF SEDGWICK, ss.

(employee of owner) or (owner or operator) of the above-described well,
being first duly sworn on oath, says: That I have knowledge of the facts, statements, and matters herein contained and the log of the above-
described well as filed and that the same are true and correct. So help me God.

(Signature) W. H. Sholtus Dist. Prod. Supt.
501 Pet. Bldg. Wichita 2, Kans
(Address)

SUBSCRIBED AND SWORN to before me this 12th day of February, 1947.

Archie Haen
Notary Public.

My commission expires November 8, 1950

15.007.01545.00.00

Great Lakes Carbon Corp.
Massey "B" 3


Located SE/4, NE/4, SE/4,
Section 27, T30S, R15W,
Barber County, Kansas.
8 5/8" Casing at 815 Ft.
Cemented with 175 Sacks
5 1/2" Casing at 4329 Ft.
Cemented with 250 Sacks

Total Depth 4363Ft.
Comm. 9/7/46
Comp. 11/24/46
Contractor R. C. Patton Co.,

Lime Rock	10
Red Bed	95
Red Shale	265
Red Bed & Shale	545
Red Bed	612
Anhydrite	623
Red Bed Shale	740
Shale	848
Shale & Shells	1570
Shale & Salt	1680
Anhydrite & Shale	1690
Lime & Shale	1888
Shale & Shells	1915
Anhydrite & Shale	1975
Lime & Shale	2080
Shale & Shells	2175
Lime & Shale 2579	2579
Shale	2830
Shale & Shells	2945
Shale	3060
Lime & Shale	3135
Lime	3564
Lime & Shale	3798
Sand	3810
Lime	3812
Lime & Shale	3973
Lime	4017
Lime & Shale	4175
Lime	4190
Lime & Shale 4229	4229
Lime	4283
Lime & Shale	4315
Lime	4363
Total Depth	4363

STATE OF Kansas COUNTY OF Sedgewick ss,

I, the undersigned, being duly sworn, on oath state that the above statement and log is a true and correct record and log of the well drilled at the location above described.

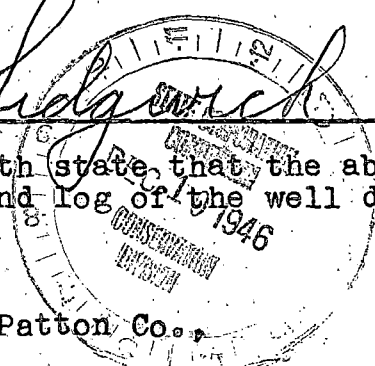

PLUGGING
FILE SEC 27 30 15W
BOOK PAGE 83 LINE 45

R. C. Patton Co.,
By R. C. Patton

Subscribed and sworn to before me this 6th day of Dec 1946

J.P. Hendrick
Notary Public

My Commission expires Oct 4th 1948