


Give All Information Completely
Make Required Affidavit
Mail or Deliver Report to:
Conservation Division
State Corporation Commission
212 No. Market
Wichita, Kansas

WELL PLUGGING RECORD

NORTH

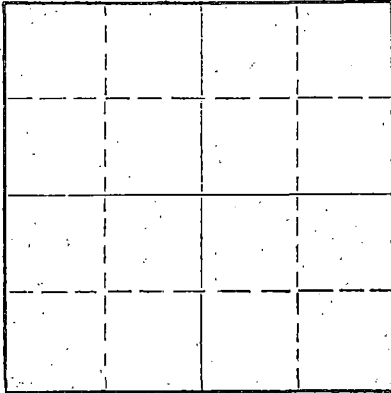

Locate well correctly on above
Section Plat

Gove County. Sec. 8 Twp. 15S Rge. (E) 26 (W)
Location as "NE/CNWxSWx" or footage from lines C/SE NE
Lease Owner Time Petroleum Company
Lease Name Jacka Well No. 3
Office Address 815 Union National Bldg., Wichita, Kansas
Character of Well (completed as Oil, Gas or Dry Hole) Dry Hole
Date well completed April 2 19 66
Application for plugging filed April 2 19 66
Application for plugging approved April 2 19 66
Plugging commenced April 2 19 66
Plugging completed April 2 19 66
Reason for abandonment of well or producing formation Dry Hole

If a producing well is abandoned, date of last production 19
Was permission obtained from the Conservation Division or its agents before plugging was commenced? Yes

Name of Conservation Agent who supervised plugging of this well W. L. Nichols, Moreland, Kansas
Producing formation Depth to top Bottom Total Depth of Well 4210 Feet
Show depth and thickness of all water, oil and gas formations.

OIL, GAS OR WATER RECORDS

CASING RECORD

FORMATION	CONTENT	FROM	TO	SIZE	PUT IN	PULLED OUT
	8-5/8"	0	214'			

Describe in detail the manner in which the well was plugged, indicating where the mud fluid was placed and the method or methods used in introducing it into the hole. If cement or other plugs were used, state the character of same and depth placed, from _____ feet to _____ feet for each plug set.

Plugged hole as follows: Plugged at 540' with 20 sacks of cement and mud to 210'; plugged with 18 sacks of cement and mud to 40'; plugged with 8 sacks of cement. Also ran 2 sacks of cement in the rat hole and 2 sacks of cement in the mouse hole. Job completed at 5:00 A. M. April 2, 1966.

RECEIVED
STATE CORPORATION COMMISSION

APR 7 1966

CONSERVATION DIVISION
Wichita, Kansas

(If additional description is necessary, use BACK of this sheet)

Name of Plugging Contractor Strata Drilling, Inc.
Address P. O. Box 355, Great Bend, Kansas

STATE OF KANSAS COUNTY OF BARTON, ss.
Jim B. McWilliams (employee of owner) or (owner/operator) of the above-described

well, being first duly sworn on oath, says: That I have knowledge of the facts, statements, and matters herein contained and the log of the above-described well as filed and that the same are true and correct. So help me God

(Signature)

Jim B. McWilliams, Secy-Treas.
P. O. Box 355, Great Bend, Kansas
(Address)

SUBSCRIBED AND SWORN TO before me this 4th day of April, 19 66

My commission expires December 14, 1969

Elaine H. Taylor Notary Public.

15.063.30080.00.00

D R I L L E R S L O G

#3 Jacka

CASING RECORD:
Ran 207.37' of used
8-5/8" surface casing.

COMPANY: Time Petroleum Company
CONTRACTOR: Strata Drilling, Inc.

DESCRIPTION: C/SE NE
Section 8-15S-26W
Gove County, Kansas

TOTAL DEPTH:
4210'

COMMENCED: March 22, 1966
COMPLETED: April 2, 1966

ELEVATION: 2325' RB

D. & A.

<u>FORMATION</u>	<u>FROM</u>	<u>TO</u>	<u>REMARKS</u>
Surface Soil	0	214	
Shale & Red Bed	214	1090	
Sand, Shale & Red Bed	1090	1760	
Anhydrite	1760	1783	
Red Bed & Shale	1783	1964	
Shale & Lime Streaks	1964	2360	
Shale & Lime	2360	3447	
Lime	3447	4095	
Lime & Shale	4095	4164	
Lime, Shale & Chert	4164	4180	
Lime	4180	4210	

Total Depth 4210'

Ran 207.37' of used 8-5/8" surface casing; set and cemented at 214' with 200 sacks of regular cement, 2% gelaand 3% calcium chloride. Plug down at 4:30 P. M. March 23, 1966. Cement circulated.

RECEIVED
STATE CORPORATION COMMISSION

APR 7 1966

CONSERVATION DIVISION
STATE OF KANSAS

Ran four drill stem tests.

D. & A.

Plugged hole as follows: Plugged at 540' with 20 sacks of cement and mud to 210'; plugged with 18 sacks of cement and mud to 40'; plugged with 8 sacks of cement. Also ran 2 sacks of cement in the rat hole and 2 sacks of cement in the mouse hole. Job completed at 5:00 A. M. April 2, 1966.

STATE OF KANSAS)
) ss.
COUNTY OF BARTON)

I certify that this is a true and correct copy of the above log to the best of my knowledge.

STRATA DRILLING, INC.

Jim B. McWilliams
Jim B. McWilliams, Secy-Treas.

Subscribed and sworn to before me this 4th day of April, 1966.

Elaine H. Taylor
Elaine H. Taylor, Notary Public

My Commission Expires:

December 14, 1969