


Give Information Completely
Make Required Affidavit
Mail or Deliver Report to:
Conservation Division
State Corporation Commission
212 North Market, Insurance Bldg.
Wichita, Kansas

WELL PLUGGING RECORD

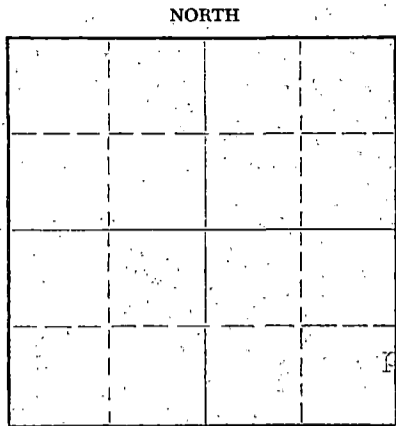

Locate well correctly on above Section Plat

Reno County. Sec 10 Twp. 23 Rge 10 (E) (W)
Location as "NE/CNW/SE" or footage from lines SW c SE
Lease Owner Morganstern & Spector
Lease Name Mc Murry Well No. 2
Office Address Russell, Kansas
Character of Well (completed as Oil, Gas or Dry Hole) oil
Date well completed 6-12-42 19
Application for plugging filed March 16, 1959 19
Application for plugging approved March 17, 1959 19
Plugging commenced 5/20/59 19
Plugging completed 5/23/59 19
Reason for abandonment of well or producing formation failure to produce profitably
If a producing well is abandoned, date of last production 19
Was permission obtained from the Conservation Division or its agents before plugging was commenced? Yes

Name of Conservation Agent who supervised plugging of this well Fred W. Hampel
Producing formation Viola Depth to top 3781 Bottom 3785 Total Depth of Well 3785 Feet
Show depth and thickness of all water, oil and gas formations.

OIL, GAS OR WATER RECORDS

CASING RECORD

FORMATION	CONTENT	FROM	TO	SIZE	PUT IN	PULLED OUT
				10 3/4" OD	277	none
				7" OD	3783	2692 feet

Describe in detail the manner in which the well was plugged, indicating where the mud fluid was placed and the method or methods used in introducing it into the hole. If cement or other plugs were used, state the character of same and depth placed, from _____ feet to _____ feet for each plug set.
Plugged back with sand to 3250 ft. Dumped 5 sacks of cement. Set Rock bridge at 260 ft. Dumped 20 sacks of cement Mudded hole up to 40 ft. dumped 15 sacks of cement.

RECEIVED
STATE CORPORATION COMMISSION
AUG 6 1959
CONSERVATION DIVISION
Wichita, Kansas

(If additional description is necessary, use BACK of this sheet)
Name of Plugging Contractor E & I Casing Pulling Co.
Address 1416 Coolidge, Great Bend, Kansas

STATE OF Kansas, COUNTY OF Russell, ss.
Morganstern & Spector (employee of owner) or (owner or operator) of the above-described well, being first duly sworn on oath, says: That I have knowledge of the facts, statements, and matters herein contained and the log of the above-described well as filed and that the same are true and correct. So help me God.

(Signature) *Morganstern & Spector*

SUBSCRIBED AND SWORN TO before me this 13th day of June, 1959 (Address)

My commission expires Dec 1, 1959 Notary Public.

PLUGGING
FILE SEC 10 T 23 R 10W
BOOK PAGE 22 LINE 14

WELL LOG BUREAU - KANSAS GEOLOGICAL SOCIETY
412 Union National Bldg., Wichita, Kansas


15-155-02177-0000

LEADER OIL CO.
M.O. McMurtry No. 2.

SEC. 10 T. 23 R. 10 W
SW 1/4 SE
330' f SL 330' f WL SE 1/4

Total Depth. 3785'
Comm. 5-26-42 Comp. 6-12-42
Shot or Treated. 6-13-42 500 Gals.
Contractor. Zephyr Drlg. Co.
Issued. 8-1-42

County. Reno

 

CASING:
10 3/4" 277' Cem.
7" 3783' Cem.

Elevation.

Production. 3HPB Pot. 15,376 F

Figures Indicate Bottom of Formations.

sand & clay	100
red bed	287
shale	395
shale & shells	1510
lime & shale	1640
lime	1740
lime & shale	1995
shale & shells	2105
lime & shale	2845
lime	3115
lime & shale	3170
shale	3280
lime	3435
lime & shale	3500
lime	3540
shale & shells	3590
lime & shale	3654
shale	3773
SLM 3773 equals 3781	
lime Viola	3781
Viola dolomite	3785
Total Depth.	

Top Viola lime 3781 (oil 3784-85)

7" csg cmtd 3783, drld plug
@ 3783, TD 3785, no new hole
made w/cable tools, no wtr
load hole filled 1800' and
made natural flow, loaded
hole to kill flow, swbd wtr
out & turned well into tank,
flowed 40 bbl oil 1st hr
30 bbl 2nd hr 25 bbl 3rd hr
Acidized w/500 Gals.
Swbd 37 BO, well kicked off
& flowed 75 bbl oil 1st hr

RECEIVED
STATE CORPORATION COMM

MAR 16 1959

CONSERVATION DIVISION
Wichita, Kansas

PLUGGING
FILE SEC 10 T 23 R 10 W
BOOK PAGE 22 LINE 14