


15095 20894-0000

STATE OF KANSAS
STATE CORPORATION COMMISSION

WELL PLUGGING RECORD

Give All Information Completely
Make Required Affidavit
Mail or Deliver Report to
Conservation Division
State Corporation Comm.
245 North Water
Wichita, KS 67202

Kingman County, Sec. 15 Twp. 29S Rge. 6 ~~XB~~/W
Location as "NE/CNW $\frac{1}{4}$ /SW $\frac{1}{4}$ " or footage from lines
NW NW SW
Lease Owner Pate-Dombaugh
Lease Name Ravenstein Well No. 1
Office Address 502 Union Center, Wichita, Ks. 67202
Character of Well (Completed as Oil, Gas or Dry Hole)
dry hole

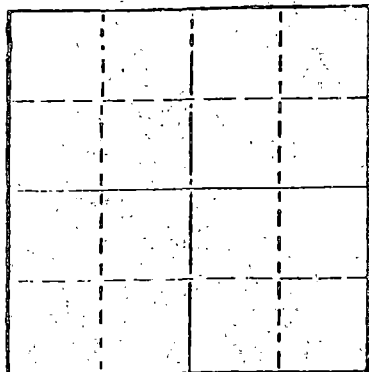

Locate well correctly on above
Section Plot

Date Well completed 10-29 1979
Application for plugging filed 10-29 1979
Application for plugging approved 10-29 1979
Plugging commenced 10-29 1979
Plugging completed 10-29 1979
Reason for abandonment of well or producing formation
no commercial quantities of oil or gas encountered
If a producing well is abandoned, date of last production
-- 19

Was permission obtained from the Conservation Division or
its agents before plugging was commenced? yes

Name of Conservation Agent who supervised plugging of this well Wm. T. Owen
Producing formation Depth to top Bottom Total Depth of Well 4147
Show depth and thickness of all water, oil and gas formations.

OIL, GAS OR WATER RECORDS

CASING RECORD

FORMATION	CONTENT	FROM	TO	SIZE	PUT IN	PULLED OUT
surface hole	shale	surf	284'	8-5/8"	283	none

Describe in detail the manner in which the well was plugged, indicating where the mud fluid
was placed and the method or methods used in introducing it into the hold. If cement or other
plugs were used, state the character of same and depth placed, from feet to
feet for each plug set.

Fluid to 290', plug, 40 sx
Fluid to 40', plug, 12 sx
Rat hole 3 sx

RECEIVED
STATE CORPORATION COMMISSION

NOV 13 1979 11-13-79

CONSERVATION DIVISION
Wichita, Kansas

(If additional description is necessary, use BACK of this sheet)

Name of Plugging Contractor D N B DRILLING, INC.
515 R. H. Garvey Building
Wichita, Kansas 67202

STATE OF Kansas COUNTY OF Sedgwick, ss.
Ella Priess (employee of owner) or (owner or operator)
of the above-described well, being first duly sworn on oath, says: That I have knowledge of
the facts, statements, and matters herein contained and the log of the above-described well
as filed and that the same are true and correct. So help me God.

(Signature) Ella Priess
515 R.H. Garvey Bldg., Wichita, Ks. 67202
(Address)

SUBSCRIBED AND SWORN TO before me this 30th day of October, 19 79

Dorothy L. Schmidt
Dorothy L. Schmidt Notary Public.

My commission expires October 30, 1983

DOROTHY L. SCHMIDT
STATE NOTARY PUBLIC
Sedgwick County, Kansas
My Appt. Exp. April 30, 1983

15-095-20894-0000

DRILLER'S LOG

PATE-DOMBAUGH
No. 1 Ravenstein
NW NW SW Sec. 15-29S-6W
Kingman Co., Ks.

Commenced: 10-19-79
Completed: 10-29-79

Surface Casing: 283' of 8-5/8"
cmtd w/275 sx cement

<u>FORMATION</u>	<u>DEPTH</u>
Surface Hole	0 - 284
Shale & Sand	284 - 660
Shale	660 - 995
Lime	995 - 1090
Shale & Lime	1090 - 2380
Lime & Shale	2380 - 3130
Shale & Lime	3130 - 3291
Lime & Shale	3291 - 3412
Lime	3412 - 3500
Lime & Shale	3500 - 3685
Lime	3685 - 3785
Lime & Shale	3785 - 3925
Lime	3925 - 4147 RTD

I do hereby certify that the foregoing statements are true and correct to the best of my knowledge and belief.

D N B DRILLING, INC.

Ella Priess
Ella Priess

STATE OF KANSAS: ss:

Subscribed and sworn to before me this 30th day of October, 1979.

RECEIVED
STATE CONSERVATION COMMISSION

NOV 13 1979

CONSERVATION DIVISION
Wildlife Kansas

Dorothy L. Schmidt
Dorothy L. Schmidt, Notary Public

DOROTHY L. SCHMIDT
STATE NOTARY PUBLIC
Sedgwick County, Kansas
My Airt. Exp. April 30, 1983