


WELL PLUGGING RECORD

15-095-01229-0000

Give All Information Completely  
Make Required Affidavit  
Mail or Deliver Report to:  
Conservation Division  
State Corporation Commission  
211 No. Broadway  
Wichita, Kansas

Kingman County, Sec. 17 Twp. 29 Rge. --7E7 6 (W)

Location as "NE/CNW%SW%" or footage from lines C-W/2 SE NE  
Lease Owner O. A. Sutton  
Lease Name Dianne McCarthy Starr Well No. 2  
Office Address 407 Insurance Bldg., Wichita, Kansas  
Character of Well (completed as Oil, Gas or Dry Hole) dry hole  
Date well completed 10-05 19 61  
Application for plugging filed 11-18 19 61  
Application for plugging approved 11-21 19 61  
Plugging commenced 11-30 19 61  
Plugging completed 12-01 19 61  
Reason for abandonment of well or producing formation

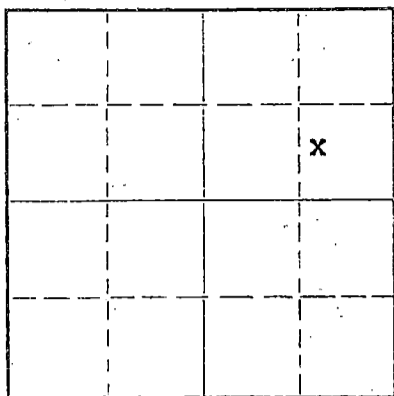

Locate well correctly on above Section Plat

If a producing well is abandoned, date of last production 19  
Was permission obtained from the Conservation Division or its agents before plugging was commenced? yes

Name of Conservation Agent who supervised plugging of this well Fred Hampel  
Producing formation Depth to top Bottom Total Depth of Well 4138 Feet  
Show depth and thickness of all water, oil and gas formations.

OIL, GAS OR WATER RECORDS

CASING RECORD

FORMATION	CONTENT	FROM	TO	SIZE	PUT IN	PULLED OUT
				8 5/8	251	none
				5 1/2	4136 1/2	3705.36

Describe in detail the manner in which the well was plugged, indicating where the mud fluid was placed and the method or methods used in introducing it into the hole. If cement or other plugs were used, state the character of same and depth placed, from feet to feet for each plug set.

Hole filled with sand to 4120 feet.  
Dumped 5 sacks cement with dump bailer.  
Set 10 foot rock bridge ~~20~~ 240 to 250 feet  
Filled to surface with ready mix cement.  
Welded cap over top of surface casing.

RECEIVED  
STATE CORPORATION COMMISSION  
DEC 11 1961  
CONSERVATION DIVISION  
Wichita, Kansas

RCWO  
12-11-61

(If additional description is necessary, use BACK of this sheet)

Name of Plugging Contractor Kent Well Servicing Co., Inc.  
Address Box 470, El Dorado, Kansas

STATE OF Kansas, COUNTY OF Butler, ss.

(employee of owner) or (owner or operator) of the above-described well, being first duly sworn on oath, says: That I have knowledge of the facts, statements, and matters herein contained and the log of the above-described well as filed and that the same are true and correct. So help me God.

(Signature) Dale R. Daniel

(Address)

SUBSCRIBED AND SWORN TO before me this 7th day of December, 19 61

Ethelene C. Phillips

Notary Public.

My commission expires June 18, 1963



15-095-01229-0000

Starr # 2 - Dianne Sutton McCarthy  
Center W/2 NE SE Section 17-29-6  
Kingman County, Kansas

Date Commenced - September 26, 1961  
Date Completed - October 5, 1961  
Elevation - 1575'  
Casing - 251' of 8-5/8" with 200 sx Completed 3 p.m. 9/26/61  
5 1/2" casing set at 4136 1/2' with 75 sx

Drillers Log

250 - 795	Red Bed/Shale
795 - 1200	Shale/Lime
1200 - 1400	Shale/Lime
1400 - 1550	Lime/Shale
1550 - 1655	Lime
1655 - 1855	Lime/Shale
1855 - 2015	Lime
2015 - 2250	Lime/Shale
2250 - 2455	Lime/Shale
2455 - 2615	Shale/Lime
2615 - 2835	Lime/Shale
2835 - 2975	Lime/Shale
2975 - 3122	Lime/Shale
3122 - 3307	Lime/Shale
3307 - 3330	Lansing
3330 - 3455	Lime
3455 - 3545	Lime
3545 - 3655	Lime/K.C.
3655 - 3695	Lime
3695 - 3756	Lime
3756 - 3810	Lime/K.C.
3810 - 3875	Lime
3875 - 3935	Lime/Shale
3935 - 4033	Lime
4033 - 4103	Lime
4103 - 4130	Lime/Shale
4130 - 4138	Miss/Chat
4138 -	Total Depth (T.D.)