


Give All Information Completely
 Make Required Affidavit
 Mail or Deliver Report to:
 Conservation Division
 State Corporation Commission
 211 No. Broadway
 Wichita, Kansas

WELL PLUGGING RECORD

15-095-01230-0000

Kingman County, Sec. 17 Twp. 29 Rge. 7E1-6(W)

Location as "NE/CNW/SW" or footage from lines C-SE NE
 Lease Owner O. A. Sutton
 Lease Name Dianne McCarthy, Starr Well No. 1
 Office Address 407, Insurance Bldg., Wichita, Kansas
 Character of Well (completed as Oil, Gas or Dry Hole) dry hole
 Date well completed 9-8 19 61
 Application for plugging filed 11-18 19 61
 Application for plugging approved 11-20 19 61
 Plugging commenced 11-27 19 61
 Plugging completed 11-29 19 61
 Reason for abandonment of well or producing formation _____

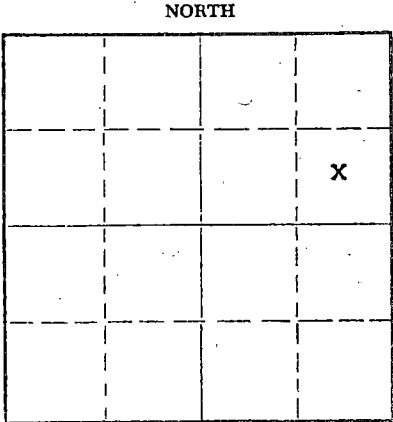

Locate well correctly on above Section Plat

If a producing well is abandoned, date of last production _____ 19____
 Was permission obtained from the Conservation Division or its agents before plugging was commenced? yes

Name of Conservation Agent who supervised plugging of this well Fred Hampel
 Producing formation _____ Depth to top _____ Bottom _____ Total Depth of Well 4250 Feet
 Show depth and thickness of all water, oil and gas formations.

OIL, GAS OR WATER RECORDS


CASING RECORD

FORMATION	CONTENT	FROM	TO	SIZE	PUT IN	PULLED OUT
				8 5/8	252	none
				5 1/2	4249	3511.44

Describe in detail the manner in which the well was plugged, indicating where the mud fluid was placed and the method or methods used in introducing it into the hole. If cement or other plugs were used, state the character of same and depth placed, from _____ feet to _____ feet for each plug set.

Plugged back with sand to 4230 feet.
Dumped 5 sacks cement with dump bailer
Set 10 foot rock bridge 240 to 250 feet.
Filled to surface with 4 yards ready mix.

REC'D
 12-11-61

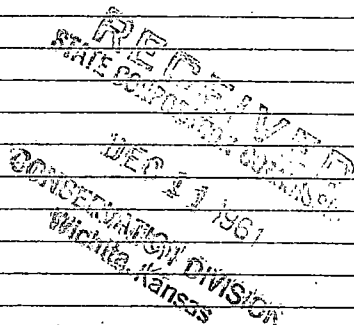

(If additional description is necessary, use BACK of this sheet)

Name of Plugging Contractor Kent Well Servicing Co., Inc.
 Address Box 470, El Dorado, Kansas

STATE OF Kansas, COUNTY OF Butler, ss.

_____, (employee of owner) or (owner or operator) of the above-described well, being first duly sworn on oath, says: That I have knowledge of the facts, statements, and matters herein contained and the log of the above-described well as filed and that the same are true and correct. So help me God.

(Signature) Dale R. Daniel

(Address)

SUBSCRIBED AND SWORN TO before me this 7th day of December, 19 61

Esther E. Phillips

My commission expires June 18, 1963

Notary Public.

15095-012300000

Starr - Dianne Sutton McCarthy
Center SE NE Section 17-29S-6W
Kingman County, Kansas

Date Commenced - August 26, 1961
Date Completed - September 8, 1961
Elevation - 1575 K.B.
Casing - 252' of 8 5/8" with 200 sacks of HA5 Cement
Completed at 4 p.m. on August 27, 1961
5 1/2" casing set 4249' with 150 sx.

Drillers Log

252 - 500	Red Bed and Shale
500 - 1020	Shale
1020 - 1055	Lime and Shale
1055 - 1277	Lime and Shale
1277 - 1470	Lime and Shale
1470 - 1645	Lime and Shale
1645 - 1800	Lime and Shale
1800 - 2035	Lime and Shale
2035 - 2310	Lime and Shale
2310 - 2476	Lime and Shale
2476 - 2670	Shale and Lime
2670 - 2865	Lime and Shale
2865 - 2995	Lime and Shale
2995 - 3180	Lime and Shale
3180 - 3340	Lime and Shale
3340 - 3435	Lime
3435 - 3500	Lime
3500 - 3605	Lime
3605 - 3685	Lime
3685 - 3740	Lime
3740 - 3790	Lime
3790 - 3840	Lime
3840 - 3871	Lime
3871 - 3918	Lime
3918 - 3995	Lime
3995 - 4075	Lime and Shale
4075 - 4151	Lime and Shale
4151 - 4151	D. S. T. # 1 4131 to 4151
4151 - 4163	Miss D. S. T. # 3
4163 - 4183	D. S. T. # 2 4151 to 4163
4183 - 4242	Miss.
4242 - 4250	Miss.
4250 -	Total Depth

RECEIVED
STATE CONSERVATION COMMISSION
NOV 21 1961
CONSERVATION DIVISION
Wichita, Kansas