


15-095-21195-0000

STATE OF KANSAS  
STATE CORPORATION COMMISSION

WELL PLUGGING RECORD

Give All Information Completely  
Make Required Affidavit  
Mail or Deliver Report to  
Conservation Division  
State Corporation Comm.  
245 North Water  
Wichita, KS 67202

Kingman County, Sec. 17 Twp. 29S Rge. 6W E/W  
Location as "NE/CNW $\frac{1}{4}$ SW $\frac{1}{4}$ " or footage from lines  
150' NE C NE NW  
Lease Owner Robert E. Campbell  
Lease Name Ewy Well No. 3  
Office Address 260 N. Rock Road Wichita, Kansas 67206  
Character of Well (Completed as Oil, Gas or Dry Hole)

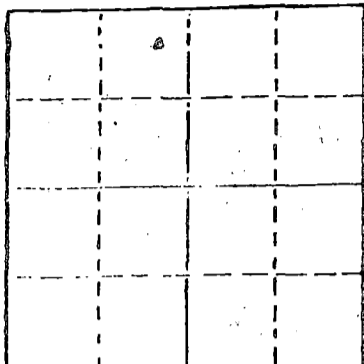

Locate well correctly on above  
Section Plot

Dry Hole  
Date Well completed 12-9-81 19  
Application for plugging filed 12-9-81 19  
Application for plugging approved 12-9-81 19  
Plugging commenced 12-9-81 19  
Plugging completed 12-9-81 19  
Reason for abandonment of well or producing formation

If a producing well is abandoned, date of last production 19

Was permission obtained from the Conservation Division or its agents before plugging was commenced? Yes

Name of Conservation Agent who supervised plugging of this well Maurice Leslie  
Producing formation Depth to top Bottom Total Depth of Well 4556'  
Show depth and thickness of all water, oil and gas formations.

OIL, GAS OR WATER RECORDS

CASING RECORD

FORMATION	CONTENT	FROM	TO	SIZE	PUT IN	PULLED OUT

Describe in detail the manner in which the well was plugged, indicating where the mud fluid was placed and the method or methods used in introducing it into the hold. If cement or other plugs were used, state the character of same and depth placed, from feet to feet for each plug set.

Mud From Bottom To 620' 60 Sacks Cement  
Mud To 210' 40 Sacks Cement  
Mud To 40' 10 Sacks Cement  
Rat Hole 10 Sacks Cement  
Mouse Hole 5 Sacks Cement

(If additional description is necessary, use BACK of this sheet)

Name of Plugging Contractor Merckle Drilling Co.


STATE OF Kansas COUNTY OF Barton, ss.  
Clyde Merckle (employee of owner) or (owner or operator  
of the above-described well, being first duly sworn on oath, says: That I have knowledge of the facts, statements, and matters herein contained and the log of the above-described well as filed and that the same are true and correct. So help me God.

(Signature) Clyde Merckle  
Box 1382 Great Bend, Kansas 67530  
(Address)

SUBSCRIBED AND SWORN TO before me this 11<sup>th</sup> day of December, 1981

Loretta Lang Notary Public.

My commission expires 3-28-81

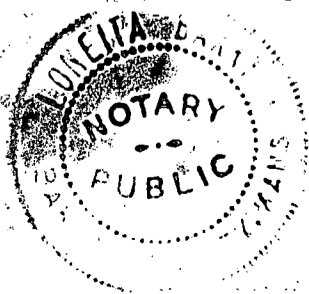

RECEIVED  
STATE CORPORATION COMMISSION

DEC 14 1981  
12-14-81  
CONSERVATION DIVISION  
Wichita, Kansas

15-095-21195-0000

Robert E. Campbell  
260 N. Rock Road  
Suite 110  
Wichita, Kansas 67206

Ewy #3

150' NE C NE NW

Section 17 Twp. 29S Rge. 6W

Kingman County

Driller's Log \_\_\_\_\_ Total Depth 4556'

0-----75 Sand

75----1030 Shale

1030---1930 Shale & Lime

1930---2600 Lime & Shale

2600---3540 Lime & Shale

3540---3982 Lime

3982---4174 Lime

4174---4556 Lime

Clyde Merckle  
Clyde Merckle