


15-09500380000

WELL PLUGGING RECORD

Give All Information Completely
Make Required Affidavit
Mail or Deliver Report to:
Conservation Division
State Corporation Commission
800 Bittling Building
Wichita, Kansas

Kingman County. Sec. 18 Twp. 29 Rge. 6 (E) (W)
Location as "NE/CNW¹/₄SW¹/₄" or footage from lines SW SW SE
Lease Owner S. A. Berwick - Aurora Gasoline Company
Lease Name Albrecht Well No. 1
Office Address P. O. Box 64, Great Bend, Kansas
Character of Well (completed as Oil, Gas or Dry Hole) Dry Hole
Date well completed September 9 19 54
Application for plugging filed September 9 19 54
Application for plugging approved Yes 19
Plugging commenced September 10 19 54
Plugging completed September 10 19 54
Reason for abandonment of well or producing formation Dry Hole

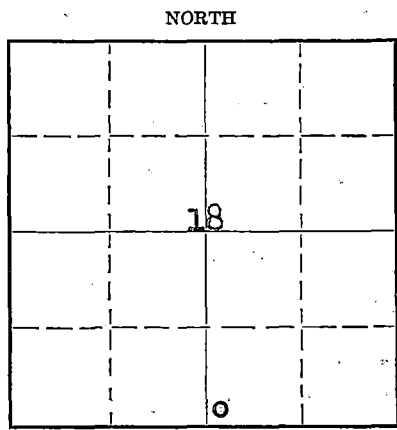

Locate well correctly on above Section Plat

If a producing well is abandoned, date of last production 19
Was permission obtained from the Conservation Division or its agents before plugging was commenced? Yes

Name of Conservation Agent who supervised plugging of this well Merle Rives
Producing formation None Depth to top - Bottom - Total Depth of Well 4700 Feet
Show depth and thickness of all water, oil and gas formations.

OIL, GAS OR WATER RECORDS

CASING RECORD

Formation	Content	From	To	Size	Put In	Pulled Out

Describe in detail the manner in which the well was plugged, indicating where the mud fluid was placed and the method or methods used in introducing it into the hole. If cement or other plugs were used, state the character of same and depth placed, from feet to feet for each plug set.

Filled Hole with heavy mud. Bridged hole 150 ft. Cemented with 20 sacks. Bridged hole 25' Cemented with 10 sacks

RECEIVED
STATE CORPORATION COMMISSION
09-16-54 SEP 16 1954
CONSERVATION DIVISION
WICHITA, KANSAS

(If additional description is necessary, use BACK of this sheet)
Correspondence regarding this well should be addressed to S. A. Berwick Drilling Company
Address Box 64, Great Bend, Kansas

STATE OF KANSAS, COUNTY OF BARTON, ss.
S. A. Berwick (employee of owner) or (owner or operator) of the above-described well,
being first duly sworn on oath, says: That I have knowledge of the facts, statements, and matters herein contained and the log of the above-described well as filed and that the same are true and correct. So help me God.
(Signature) S. A. Berwick
Box 64, Great Bend, Kansas (Address)

SUBSCRIBED AND SWORN to before me this 15th day of September, 19 54
John W. P... Notary Public.

My commission expires April 11, 1955

23-5091-s 8-50-10M
PLUGGING
FILED SEC 18 T 29 R 6W
BOOK PAGE 103 LINE 26

15-095-003800000

BERWICK DRILLING COMPANY and AURORA GASOLINE COMPANY
1105 Williams
Great Bend, Kansas

Albrecht No. 1

SW SW SE Sec. 18-29-6
Kingman County, Kansas
Elevation: 1564' D. F.
Initial Prod: Dry
Contractor: S. A. Berwick
Drilling Co.

Total Depth: 4700'
Commenced R. D.: 8-22-54
Completed R. D.: 9-9-54

Strata	Depth
Sand	0- 75
Shale and Shells	75- 160
Shale and Sand	160- 320
Red Bed	320- 450
Shale and Shells	450-1060
Lime	1060-1220
Shale and Shells	1220-1560
Sand	1560-1595
Shale and Sand	1595-1630
Lime and Shale	1630-2060
Shale and Shells	2060-2830
Shale and Lime Shells	2830-2945
Shale and Shells	2945-3050
Shale	3050-3205
Shale and Sand	3205-3262
Lime	3262-3289
Lime and Shale	3289-3485
Lime	3485-3770
Lime and Shale	3770-3935
Lime	3935-4000
Lime and Shale	4000-4098
Lime	4098-4145
Chert and Lime	4145-4180
Lime	4180-4278
Chert and Lime	4278-4320
Lime	4320-4425
Lime and Shale	4425-4516
Sand and Chert	4516-4525
Lime	4525-4545
Sand and Lime	4545-4589
Shale	4589-4605
Sand and Lime	4605-4614
Lime	4614-4623
Lime and Shale	4623-4640
Shale and Sand	4640-4666
Lime	4666-4700

RECEIVED
STATE CORPORATION COMMISSION
SEP 16 1954
CONSERVATION DIVISION
Wichita, Kansas

I hereby certify the above a true and correct log of said well as reflected by the daily drilling report.

PLUGGING
WELL SEC 18 T 29 R 6W
BOOK PAGE 63 LINE 26

S. A. BERWICK DRILLING COMPANY
By S. A. Berwick
Owner

Signed and sworn to in my presence this 15th day of September, 1954, by S. A. Berwick, owner of the S. A. Berwick Drilling Company.

My Commission Expires: April 11, 1955
John W. [Signature]
Notary Public