

STATE OF KANSAS
STATE CORPORATION COMMISSION


15-155-20547-0000

WELL PLUGGING RECORD

Give All Information Completely
Make Required Affidavit
Mail or Deliver Report to
Conservation Division
State Corporation Comm.
245 North Water
Wichita, KS 67202

Reno County, Sec. 30 Twp. 23S Rge. 9W E/W
Location as "NE/CNW $\frac{1}{4}$ SW $\frac{1}{4}$ " or footage from lines
SE NE NE

Lease Owner Zenith Drilling Corporation, Inc.
Lease Name Stiggins #1 Well No. 1
Office Address Suite 600, 200 West Douglas, Wichita, Ks 67579
Character of Well (Completed as Oil, Gas or Dry Hole)
Dry Hole

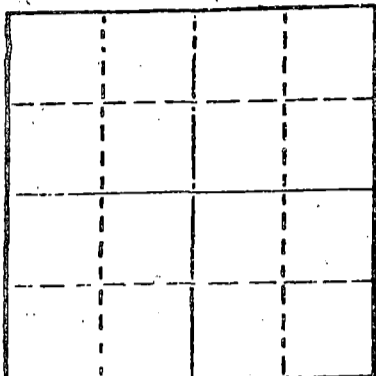

Locate well correctly on above
Section Plat

Date Well completed August 25, 1978 19
Application for plugging filed August 25, 1978 19
Application for plugging approved August 25, 1978 19
Plugging commenced 12:00 Noon, August 25, 1978 19
Plugging completed 1:45 PM, August 25, 1978 19
Reason for abandonment of well or producing formation
Dry Hole

If a producing well is abandoned, date of last production 19

Was permission obtained from the Conservation Division or
its agents before plugging was commenced? Yes

Name of Conservation Agent who supervised plugging of this well Gilbert Toman
Producing formation _____ Depth to top _____ Bottom _____ Total Depth of Well 3750'
Show depth and thickness of all water, oil and gas formations.

OIL, GAS OR WATER RECORDS

CASING RECORD

FORMATION	CONTENT	FROM	TO	SIZE	PUT IN	PULLED OUT
				8 5/8"	253'	None

Describe in detail the manner in which the well was plugged, indicating where the mud fluid
was placed and the method or methods used in introducing it into the hold. If cement or other
plugs were used, state the character of same and depth placed, from _____ feet to
_____ feet for each plug set.

Filled hole with heavy mud.
Spotted 40 sacks cement through open
end drill pipe at 500'. 25 sacks at
240'. Solid Bridge at 40' using 1/2
sack hulls, Howco plug and 10 sacks.
2 sacks in rat hole.

RECEIVED
STATE CORPORATION COMMISSION

AUG 29 1978
CONSERVATION DIVISION
Wichita, Kansas

8-29-78

(If additional description is necessary, use BACK of this sheet)

Name of Plugging Contractor Sterling Drilling Company
P. O. Box 129, Sterling, Kansas 67579

STATE OF KANSAS COUNTY OF RICE ss.

F. A. Wuellner (employee of owner) or (owner or operator) of the above-described
well, being first duly sworn on oath, says: That I have knowledge of the facts, statements, and matters herein contained and the log of the
above-described well as filed and that the same are true and correct. So help me God. STERLING DRILLING COMPANY

(Signature) *F. A. Wuellner*
F. A. Wuellner, Secretary
P. O. Box 129, Sterling, Kansas 67579
(Address)

Subscribed and Sworn to before me this 26th day of August 1978.

My commission expires



Charles M. Hall
Charles M. Hall, Notary Public.

STERLING DRILLING COMPANY
P. O. Box 129
Sterling, Kansas 67579

15-155-20547-0000

WELL LOG - - - - - STIGGINS #1
Located: SE NE NE, Section 30-23S-9W, Reno County, Kansas

OWNER: Zenith Drilling Corporation, Inc.
ROTARY DRILLING CONTRACTOR: Sterling Drilling Company

COMMENCED: August 18, 1978
COMPLETED: August 25, 1978

TOTAL DEPTH: 3750'

<u>LOG</u>	<u>CASING RECORD</u>
0 - 256 Sand, Shale, Red Bed	Ran 6 joints 8 5/8" casing, 240.93' set
256 - 360 Red Bed and Shale	at 253' K.B. with 200 sacks 60/10 Pozmix
360 - 1542 Shale	with 3% cc. Plug down at 4:15 PM, 8-18-78,
1542 - 1950 Lime and Shale	by Howco.
1950 - 2210 Lime	
2210 - 2630 Lime and Shale	
2630 - 3750 Lime	Plugged.

RECEIVED
STATE CORPORATION COMMISSION

AUG 29 1978

CONSERVATION DIVISION
Wichita, Kansas