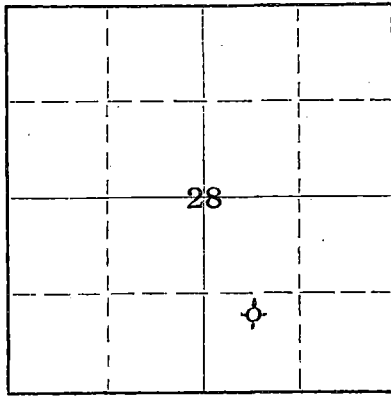


STATE OF KANSAS  
STATE CORPORATION COMMISSION

Give All Information Completely  
Make Required Affidavit  
Mail or Deliver Report to:  
Conservation Division  
State Corporation Commission  
212 No. Market  
Wichita, Kansas

## WELL PLUGGING RECORD

NORTH

Locate well correctly on above  
Section Plat

Reno County, Sec. 28 Twp. 23S Rge. (E) 9 (W)  
Location as "NE/CNW%SW%" or footage from lines. N 2 SW SE  
Lease Owner Beardmore Drilling Company  
Lease Name HOLMES Well No. 1  
Office Address 700 One Twenty Bldg., Wichita, Kansas  
Character of Well (completed as Oil, Gas or Dry Hole) Dry Hole  
Date well completed 9-8 19 68  
Application for plugging filed 9-8 19 68  
Application for plugging approved 9-8 19 68  
Plugging commenced 9-8 19 68  
Plugging completed 9:00 PM 9-8 19 68  
Reason for abandonment of well or producing formation No oil or gas found  
in commercial quantities.  
If a producing well is abandoned, date of last production -- -- 19 --  
Was permission obtained from the Conservation Division or its agents before plugging was commenced? Yes  
Name of Conservation Agent who supervised plugging of this well Hugh Scott - McPherson, Kansas  
Producing formation None Depth to top Bottom Total Depth of Well 3788 Feet  
Show depth and thickness of all water, oil and gas formations.

## OIL, GAS OR WATER RECORDS

## CASING RECORD

FORMATION	CONTENT	FROM	TO	SIZE	PUT IN	PULLED OUT
				8-5/8"	239'	-0-

Describe in detail the manner in which the well was plugged, indicating where the mud fluid was placed and the method or methods used in introducing it into the hole. If cement or other plugs were used, state the character of same and depth placed, from feet to feet for each plug set.

Mud back to 225' and set plug and 25 sacks cement.  
Mud back to 40'. Set solid bridge and capped with  
10 sacks, 2 sacks in rat hole.

RECEIVED  
STATE CORPORATION COMMISSION  
SEP 18 1968  
CONSERVATION DIVISION  
Wichita, Kansas

(If additional description is necessary, use BACK of this sheet)

Name of Plugging Contractor Rains & Williamson Oil Co., Inc.  
Address 1425 Wichita Plaza - Wichita, Kansas 67202

STATE OF KANSAS, COUNTY OF SEDGWICK, ss.  
Wilson Rains (employee of owner) or (owner or operator) of the above-described well, being first duly sworn on oath, says: That I have knowledge of the facts, statements, and matters herein contained and the log of the above-described well as filed and that the same are true and correct. So help me God.  
(Signature) Wilson Rains  
1425 Wichita Plaza - Wichita, Kansas

SUBSCRIBED AND SWORN TO before me this 9 day of September, 19 68

My commission expires 6-30-71

Sherry Gish

Notary Public.

15-155-20075-0000

ROTARY DRILLING LOG

Operator: Beardmore Drilling  
Company  
HOLMES #1  
N $\frac{1}{2}$  SW SE 28-23S-9W  
Reno County, Kansas

Contractor: Rains & Williamson  
Oil Co., Inc.

Commenced: 8-31-68

Completed: 9-8-68

Remarks: Set 8-5/8" casing  
at 239' w/200 sx.

Formations

Surface Soil	10'
Shale	70'
Sand	141'
Shale	241'
Red Bed	430'
Blue Shale	700'
Shale and Shells	1110'
Shale	1375'
Shale and Lime	1540'
Lime and Shale	1950'
Shale and Lime	2950'
Lime and Shale	3028'
Lime	3086'
Lime and Shale	3310'
Lime	3788'

Rotary Total Depth (D&A) 3788'

RECEIVED  
STATE CORPORATION COMMISSION

SEP 18 1968


CONSERVATION DIVISION  
Wichita, Kansas

We certify the above log is  
true and correct to the best  
of our knowledge and belief.

RAINS & WILLIAMSON OIL CO., INC.

  
Wilson Rains

Subscribed and sworn to before me, a Notary Public within and for the  
State of Kansas, County of Sedgwick, this 9th day of September, 1968.

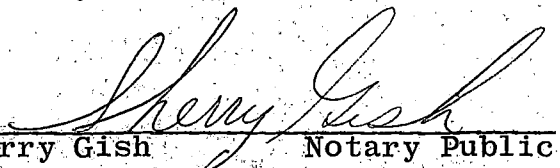  
Sherry Gish Notary Public

My Commission Expires:  
June 30, 1971