


STATE OF KANSAS
STATE CORPORATION COMMISSION

WELL PLUGGING RECORD

Give All Information Completely
Make Required Affidavit
Mail or Deliver Report to:
Conservation Division
State Corporation Commission
800 Biting Building
Wichita, Kansas

Reno County. Sec. 11 Twp. 24S Rge. (E) 4 (W)

Location as "NE/CNW $\frac{1}{4}$ SW $\frac{1}{4}$ " or footage from lines NW - NE - NE
Lease Owner Plains Exploration Co.
Lease Name Baker Well No. 1
Office Address Denver, Colorado
Character of Well (completed as Oil, Gas or Dry Hole) Dry Hole
Date well completed 8 - 4 - 55 19
Application for plugging filed 10 - 10 - 55 19
Application for plugging approved 10 - 10 - 55 19
Plugging commenced 10 - 11 - 55 19
Plugging completed 10 - 21 - 55 19
Reason for abandonment of well or producing formation Dry Hole

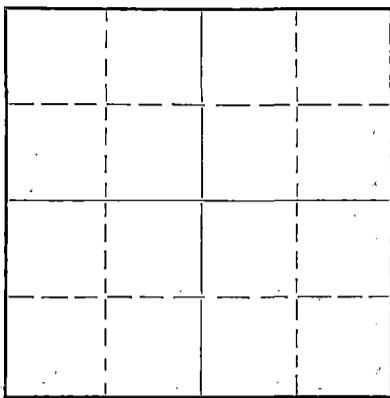

Locate well correctly on above
Section Plat

If a producing well is abandoned, date of last production 19
Was permission obtained from the Conservation Division or its agents before plugging was commenced? Yes

Name of Conservation Agent who supervised plugging of this well Ruel E. Durkee
Producing formation Depth to top Bottom Total Depth of Well 3388 Feet
Show depth and thickness of all water, oil and gas formations.

OIL, GAS OR WATER RECORDS

CASING RECORD

Formation	Content	From	To	Size	Put In	Pulled Out
				10 3/4"	291'	None
Mississippi		3293'	T.D.	5 1/2"	3303'	2920'

Describe in detail the manner in which the well was plugged, indicating where the mud fluid was placed and the method or methods used in introducing it into the hole. If cement or other plugs were used, state the character of same and depth placed, from feet to feet for each plug set.

Sand from 3388' to 3310'
Dumped 6 sks of cement
Mudded hole to 285'
Made rock bridge at 285'
Dumped 20 sks of cement
Mudded hole to 15' below bottom of cellar
Dumped 5 sks of cement in top of surface pipe

(If additional description is necessary, use BACK of this sheet)

Correspondence regarding this well should be addressed to Plains Exploration Co.
Address 525 University Building, Denver 2, Colorado

STATE OF Kansas, COUNTY OF Stafford, ss.
E. E. Duncan (employee of owner) or (owner or operator) of the above-described well,
being first duly sworn on oath, says: That I have knowledge of the facts, statements, and matters herein contained and the log of the above-described well as filed and that the same are true and correct. So help me God.
(Signature) *E. E. Duncan*
By: E. E. Duncan, Prod. Supt.
Stafford, Kansas (Address)

SUBSCRIBED AND SWORN to before me this 31 day of Oct, 1955

My commission expires Aug 4, 1958 22-7877-S 4-49-10M Notary Public.

PLUGGING
FILE SEC 10124 R42
BOOK PAGE 6 LINE 15

RECEIVED
STATE CORPORATION COMMISSION
NOV - 1 1955 11-1-55
CONSERVATION DIVISION
Wichita, Kansas

WELL LOG-----BAKER #1

Location: NW NE NE, Section 10-24-4W,
Reno County, Kansas

OWNER: Plains Exploration Company
 PRIMARY DRILLING CONTRACTOR: Group Exploration Company

COMMENCED: 7-16-55 (w.r.)
 COMPLETED: 7-27-55 (w.r.)

TOTAL DEPTH: 3303'

LOG

0-200	Sand
200-280	Shale
280-520	Shale & Salt
520-980	Limestone & Shale
980-1100	Limestone
1100-1245	Limestone & Shale
1245-1430	Shale & Shells
1430-2030	Limestone & Shale
2030-2335	Limestone
2335-2550	Shale & Limestone
2550-2715	Shale
2715-3200	Limestone
3200-3293	Limestone & Shale
3293-3303	Chat

T.D.

CASING RECORD

Ran 291' of 10-3/4" casing cemented
with 180 sacks cement.

Set 3319' of 5-1/2" casing with
50 sacks cement.

3388 T.D.

PLUGGING
 REL SEC 10-24-4W
 BOOK PAGE 6 LINE 15

RECEIVED
 STATE CORPORATION COMMISSION
 OCT 22 1955
 CONSERVATION DIVISION
 WICHITA, KANSAS

RECEIVED
 STATE CORPORATION COMMISSION
 OCT 6 - 1955
 CONSERVATION DIVISION
 Wichita, Kansas

Durkee